11285 CA-1 TENANT IMPROVEMENTS

CODE DATA

FIRE RESISTANCE RATING FOR BUILDING ELEMENTS PER CBC 2016 TABLE 601& 602

ROOF CONSTRUCTION & SECONDARY MEMBERS 0 HR

PROVIDED FOR TYPE V-B CONSTRUCTION TYPE & A	-2 OCCUPANCY	
PRIMARY STRUCTURAL FRAME	0 HR	FOR REFERENCE, NO WORK IN PROJECT SCOPE
EXTERIOR BEARING WALL	0 HR	FOR REFERENCE, NO WORK IN PROJECT SCOPE
INTERIOR BEARING WALL	0 HR	FOR REFERENCE, NO WORK IN PROJECT SCOPE
EXTERIOR NONBEARING WALL/PARTITION		
X < 5'	1 HR	FOR REFERENCE, NO WORK IN PROJECT SCOPE
$5 \le X < 10$	1 HR	FOR REFERENCE, NO WORK IN PROJECT SCOPE
$10 \le X < 30$	0 HR	FOR REFERENCE, NO WORK IN PROJECT SCOPE
X ≥ 30	0 HR	FOR REFERENCE, NO WORK IN PROJECT SCOPE
INTERIOR NONBEARING WALL/PARTITION	0 HR	
FLOOR CONSTRUCTION & SECONDARY MEMBERS	0 HR	FOR REFERENCE, NO WORK IN PROJECT SCOPE

INTERIOR WALL AND CEILING FINISH REQUIREMENT BASED ON OCCUANCY PER TABLE 803.13

GROUP A-2 OCCUPANCY, NONSPRINKLERED		
INTERIOR EXIT STAIRWAYS/RAMPS/PASSAGEWAYS:	Α	
CORRIDORS/ENCLOSURES FOR EXIT ACCESS STAIRWAYS/RAMPS:	Α	
ROOMS/ENCLOSED SPACES	C*	

0-450

*BASE CODE REQUIREMENT = CLASS B, TABLE 803.13 FOOTNOTE E ALLOWS CLASS B FOR ASSEMBLY WITH OCCUPANT LOAD < 300

DAVIS NO. C28439

REN. 09-30-21

GROUP B OCCUPAN	ICY, NONSPRINKLERED			
INTERIOR EXIT STAIF	RWAYS/RAMPS/PASSAGE	WAYS:	Α	
CORRIDORS/ENCLO	SURES FOR EXIT ACCES	S STAIRWAYS/RAMPS:	В	
ROOMS/ENCLOSED	SPACES		С	
CLASSIFICATION SH	ALL BE IN ACCORDANCE	WITH ASTM E84 OR UL 723		
CLASS	FLAME SPREAD	SMOKE DEVELOPED		
Α	0-25	0-450		
R	26-75	0-450		

INTERIOR FLOOR FINISH PER SECTION 804

PER SECTION 804.1, EXCEPTION: CLASSIFICATION OF FLOOR FINISHES AND COVERINGS OF A TRADITIONAL TYPE, SUCH AS WOOD, VINYL, LINOLEUM, TERAZZO AND RESILIENT FLOOR COVERING MATERIALS THAT ARE NOT COMPRISED OF FIBERS

FOR REFERENCE, NO WORK IN PROJECT SCOP

NON INFRINGEMENT STATEMENT

76-200

THE SCOPE OF WORK TO BE PERFORMED DOES NOT INFRINGE ON THE EXISTING LIFE-SAFETY SYSTEMS FOR THE BUILDING. THE ARCHITECT OR ENGINEER SHALL BE RESPONSIBLE FOR REVIEWING AND COORDINATION OF ALL SUBMITTED DOCUMENTS PREPARED BY OTHERS, INCLUDING DEFERRED SUBMITTAL ITEMS, FOR COMPATIBILIT WITH THE DESIGN OF THE BUILDING.

ANDREW J. DAVIS FLUID STUDIOS, LLP PO BOX 167 FOREST KNOLLS, CA 94933

CODES


2019 CALIFORNIA BUILDING CODE 2019 CALIFORNIA MECHANICAL CODE 2019 CALIFORNIA PLUMBING CODE 2019 CALIFORNIA ELECTRICAL CODE 2019 CALIFORNIA ENERGY CODE ALL OF THE ABOVE AS ADOPTED BY THE COUNTY OF MARIN

PROJECT DESCRIPTION INTERIOR RENOVATION OF EXISTING RESTAURANT, INCLUDING EXPANSION INTO

ADJACENT TENANT SPACE, RELOCATION OF NON-LOAD-BEARING WALLS, REPLACEMENT OF SELECTED EXISTING EQUIPMENT, FINISHES, AND APPLIANCES AND CONSTRUCTION OF NEW RESTROOMS. EXTERIOR WORK CONSISTS OF NEW / REPLACEMENT ROOF-MOUNTED MECHANICAL EQUIPMENT. PARKING TO BE PROVIDED AT REMOTE PARKING LOT.

PROJECT DATA

ADDRESS:	11285 CA-1 POINT REYES STATION, CA 94952
APN:	119-226-01
ZONING:	C-VCR-B2
YEAR BUILT:	1973 (PER ASSESSOR RECORDS)
CONSTRUCTION TYPE:	TYPE V-B
FIRE SPRINKLERS:	NO
AREA, BUILDING:	LEVEL 1: 4,238 SQ. FT. (NO CHANGE) LEVEL 2: 819 SQ. FT. (NO CHANGE) TOTAL: 5,058 SQ. FT. (NO CHANGE)
STORIES, AREA OF WORK	1
STORIES, BUILDING:	2 (NO CHANGE)
HEIGHT, BUILDING:	20'-10" (TO TOP OF RIDGE)
OCCUPANCY:	A-2, B (NO CHANGE)
WALL & CEILING FINISH:	CLASS C
PARKING:	18 STALLS, REMOTE (PROVIDED AT 60 4TH ST, APN 119-222-08)

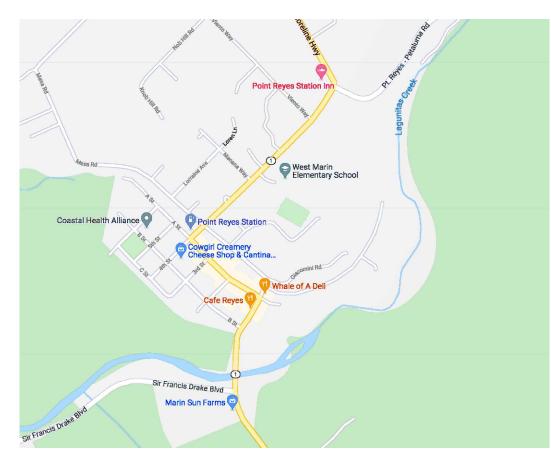


EXISTING BUILDING



DRAWING INDEX

			USE PERMIT	KITCHEN PERMIT	PRICING SET	USE PERMIT PLAN CHECK-1	
	SHEET	TITLE	2020.12.28	2021.01.28	2021.04.02		-
	T1.1	TITLE SHEET, GENERAL INFO, INDEX	•	•	•	•	\wedge
	T1.2 T1.3	GENERAL CONDITIONS, ABBREVIATIONS & SYMBOLS SURVEY - SUBJECT PROPERTY	•	•	•	•	$\frac{1}{\sqrt{1}}$
	T1.4	SURVEY - REMOTE PARKING SITE				•	
	T2.1 T2.2	CONTEXT PLAN EXISTING SITE PLAN	•	•	•	•	
	T2.3	PROPOSED SITE PLAN	~• ~	• ••••	•	~ • ~	$\sqrt{\frac{1}{1}}$
	T2.4 T2.5	REMOTE PARKING EXISTING SITE PLAN REMOTE PARKING PROPOSED SITE PLAN				•	}
>	T2.6	BUILDING CODE ANALYSIS - BUILDING PLANS	•	•	•	•	
	T2.7	PLUMBING FIXTURE ANALYSIS & AREA OF WORK	•	•	•	•	
	T1.6A	ADA COMPLIANCE DETAILS		•	•		
	T1.6B T1.6C	ADA COMPLIANCE DETAILS ADA COMPLIANCE DETAILS		•	•		
	T1.6D	ADA COMPLIANCE DETAILS		•	•		
	T1.6E	ADA COMPLIANCE DETAILS		•	•		
	T1.6G	ADA COMPLIANCE DETAILS		•	•		
	FS-T1	FOOD SERVICE NOTES		•	•		
	FS-1 FS-2	FOOD SERVICE EQUIPMENT FLOOR PLAN FOOD SERVICE EQUIPMENT SCHEDULE		•	•		
	FS-3	FOOD SERVICE EQUIPMENT PLUMBING PLAN		•	•		
	FS-4	FOOD SERVICE EQUIPMENT ELECTRICAL PLAN		•	•		
	FS-5 FS-6	FOOD SERVICE EQUIPMENT WALL BACKING FOOD SERVICE EQUIPMENT ELEVATIONS		•	•		
	FS-6.1	FOOD SERVICE EQUIPMENT ELEVATIONS		•	•		
	FS-7 FS-7.1	EXHAUST HOOD & MAKE-UP AIR SYSTEM EXHAUST HOOD & MAKE-UP AIR SYSTEM		•	•		
	FS-7.2	EXHAUST HOOD & MAKE-UP AIR SYSTEM		•	•		
	FS-7.3 FS-7.4	EXHAUST HOOD & MAKE-UP AIR SYSTEM EXHAUST HOOD & MAKE-UP AIR SYSTEM		•	•		
)	FS-7.5	EXHAUST HOOD & MAKE-UP AIR SYSTEM		•	•		
	A2.1	EXISTING/DEMO L1 PLAN	•	•	•	•	
	A2.2	EXISTING/DEMO L1 RCP	•	•	•	•	
	A2.3 A2.4	REFERENCE L2 PLAN EXISTING/DEMO ROOF PLAN	•	•	•	•	
	A2.4 A2.5	PROPOSED L1 PLAN	•	•	•	•	
	A2.5A	L1 LAYOUT & FRAMING PLAN		•	•		
	A2.5B A2.5C	L1 CEILING FRAMING PLAN FLOOR FINISH PLAN		•	•		
	A2.6	PROPOSED L1 RCP	•	•	•	•	
	A2.6A A2.7	L1 PHOTOMETRIC CALC PLAN PROPOSED ROOF PLAN	•	•	•	•	
	A3.1	EXISTING EXTERIOR ELEVATIONS			_	•	
	A3.1 A3.2	EXISTING EXTERIOR ELEVATIONS	•	•	•	•	
	A3.3	PROPOSED EXTERIOR ELEVATIONS	•	•	•	•	
	A4.1	BUILDING SECTIONS	•	•	•	•	
	A4.2	BUILDING SECTIONS	•	•	•	•	
	A5.1	INTERIOR ELEVATIONS		•	•		
	A5.2 A5.3	INTERIOR ELEVATIONS INTERIOR ELEVATIONS		•	•		
	A5.4	INTERIOR ELEVATIONS		•	•		
	A5.5 A5.6	INTERIOR ELEVATIONS INTERIOR ELEVATIONS		•	•		
	A5.7	INTERIOR ELEVATIONS		•	•		
	A7.1	SCHEDULES		•	•		
	A10.1A	TYPICAL STRUCTURAL DETAILS		•	•		
	A10.1B	TYPICAL STRUCTURAL DETAILS		•	•		
	A10.2 A10.3	TYPICAL ACOUSTIC CEILING TILE DETAILS DETAILS		•	•		
	A11.1	PROCEDURES, MATERIALS, SYSTEMS & PRODUCTS					
				•			
	M0.0 M0.1	MECHANICAL GENERAL NOTES MECHANICAL DETAILS			•		
	M1.1 M1.2	MECHANICAL PLAN - 1ST FLOOR MECHANICAL PLAN- ROOF			•		
					•		
	E0.1 E0.2	ELECTRICAL GENERAL NOTES ELECTRICAL DIAGRAMS & SCHEDULES			•		
	E1.1	ELECTRICAL DEMO PLAN - LEVEL 1			•		
	E1.2 E1.3	ELECTRICAL DEMO PLAN - LEVEL 2 ELECTRICAL DEMO PLAN - ROOF			•		
	E2.1	POWER & SIGNAL PLAN - LEVEL 1			•		
	E2.3 E3.1	POWER & SIGNAL PLAN - ROOF LIGHTING PLAN - LEVEL 1			•		
	LU. I	LIGHTHING FLAIN - LEVEL I			•		

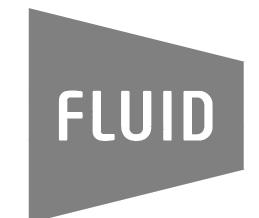

FLUID STUDIOS LLP PO BOX 167 FOREST KNOLLS

PROJECT SPONSOR Station House Cafe attn: Sheryl Cahill 11285 CA-1 Pt. Reyes Station CA 94956 cell: (707) 477-5496 email: sheryl@stationhousecafe.com

ARCHITECT Fluid Studios, LLP Attn: Andrew Davis PO Box 167 Forest Knolls, CA 94933 415.250.1855 andrew@fluid-studios.com

2021.04.16 - USE PERMIT COMMENTS

11285 CA-1 PT REYES STATION CA 94952 APN 119-226-01

> **TENANT IMPROVEMENTS**

NOT FOR CONSTRUCTION

SCALE: AS NOTED

TITLE & GENERAL INFORMATION

SHEET


GENERAL CONDITIONS

- 1. THESE SPECIFICATIONS ARE FOR THE 11285 CA-1 TENANT IMPROVEMENT PROJECT, PT REYES STATION, CA.
- 2. ALL APPLICABLE PROVISIONS OF THE CALIFORNIA BUILDING CODE, CURRENT EDITION AND AS ADOPTED BY THE COUNTY OF MARIN SHALL BE ADHERED TO IN THE CONSTRUCTION OF THIS PROJECT. IT IS THE CONTRACTORS ULTIMATE RESPONSIBILITY T CONSTRUCT THE PROJECT PER THESE CODES.
- 3. THE CONTRACTOR SHALL COMPLY WITH ALL APPLICABLE CODES AND ORDINANCES. CONTRACTOR SHALL PAY ALL FEES, MIS COSTS, AND OBTAIN AND PAY FOR ALL PERMITS NECESSARY TO COMPLETE ALL WORK, WITH THE EXCEPTION OF THE BUILDING PERMIT WHICH THE OWNER SHALL PAY FOR PRIOR TO THE START OF WORK. BEFORE FINAL ACCEPTANCE OF ANY PART OF THE WORK, THE CONTRACTOR SHALL FURNISH THE OWNER WITH ALL APPROPRIATE CERTIFICATES OF INSPECTION STATING THAT TI WORK HAS BEEN INSPECTED AND APPROVED BY THE BUILDING DEPARTMENT.
- 4. THE CONTRACTOR SHALL CARRY IN FORCE ALL NEEDED INSURANCE, LICENSES, FEES, PERMITS AND TAXES AS REQUIRED BY LAW FOR THE DURATION OF THE PROJECT.
- 5. THE CONTRACTOR SHALL MAINTAIN LIABILITY INSURANCE TO PROTECT HIMSELF AND HOLD THE OWNER AND THE ARCHITECT HARMLESS FROM ANY AND ALL CLAIMS FOR DAMAGES, FOR PERSONAL BODILY INJURY OR DEATH, OR PROPERTY DAMAGE DURING THE COURSE OF THE CONTRACT FOR CONSTRUCTION.
- 6. THE CONTRACTOR SHALL PROVIDE SUFFICIENT MEANS FOR PROTECTING EXISTING EXPOSED INTERIOR FINISHES AND NEW CONSTRUCTION AND MATERIALS FROM DAMAGE BY OTHER TRADES, WEATHER, OR VANDALS FOR THE COURSE OF THE PROJECT
- 7. ALL FIXTURES, FINISHES, INSULATION, HARDWARE, EQUIPMENT, APPLIANCES, AND MISCELLANEOUS ITEMS SHALL BE SELECT AND OR APPROVED BY THE OWNER UNLESS NOTED ON PLANS OR THESE SPECIFICATIONS.
- 8. THE CONTRACTOR SHALL MAKE THE PROPERTY OWNER, SCHOOL ADMINISTRATION, AND IMMEDIATE NEIGHBORS AWARE 24 HOURS IN ADVANCE OF CONSTRUCTION ACTIVITIES THAT ARE POTENTIALLY DISRUPTIVE.
- 9. THE ARCHITECT WILL IN NO WAY BE RESPONSIBLE FOR HOW THE WORK IS PERFORMED, SAFETY IN ON OR ABOUT THE JOB S METHODS OF PERFORMANCE OR TIMELINESS IN THE PERFORMANCE OF THE WORK.
- 10. SHOP AND FIELD WORK SHALL BE PERFORMED BY MECHANICS, CRAFTSMEN, AND WORKERS SKILLED AND EXPERIENCED IN THE FABRICATION AND INSTALLATION OF THE WORK INVOLVED. ALL WORK ON THIS PROJECT SHALL BE PERFORMED IN ACCORDANCE WITH THE BEST ACCEPTED PRACTICES OF THE VARIOUS TRADES INVOLVED AND IN ACCORDANCE WITH THESE DRAWINGS, ANY SHOP DRAWINGS, AND THESE SPECIFICATIONS.
- 11. THE ARCHITECT RESERVES THE RIGHT TO REJECT ANY MATERIALS AND WORK QUALITY WHICH ARE NOT CONSIDERED TO BE UP TO THE HIGHEST STANDARDS OF THE VARIOUS TRADES INVOLVED. SUCH INFERIOR MATERIAL OR WORK QUALITY SHALL BE REPAIRED OR REPLACED, AS DIRECTED, AT NO ADDITIONAL COST TO THE OWNER.
- 12. THESE CONSTRUCTION DOCUMENTS ARE BASED ON OBSERVATION AND DOCUMENTATION OF EXISTING CONDITIONS BY THE ARCHITECT. THE ARCHITECT FOR THIS PROJECT MAKES NO CLAIMS THAT THE INFORMATION SHOWN ON THESE DRAWINGS ACCURATELY PORTRAYS THE ACTUAL CONSTRUCTION. SHOULD THE CONTRACTOR ENCOUNTER FIELD CONDITIONS WHICH VA FROM THESE CONSTRUCTION DOCUMENTS WHICH EFFECT THE INTENT OF THESE DRAWINGS OR THE CONTRACT SUM, THE ARCHITECT SHOULD BE NOTIFIED IMMEDIATELY. THE CONTRACTOR SHALL VERIFY DIMENSIONS AGAINST FIELD CONDITIONS. A TRADES SHALL VERIFY AT THE PROJECT SITE CONDITIONS AND MEASUREMENTS RELATED TO THEIR WORK.
- 13. THE CONTRACTOR SHALL NOT SCALE THE DRAWINGS. ANY NEW AND EXISTING WALLS OR FLOOR AND CEILING SURFACES ARE TO ALIGN WITH EXISTING ADJACENT SURFACES.
- 14. THE CONTRACTOR SHALL BE RESPONSIBLE FOR THE ACCURACY OF THE BUILDING LINES AND LEVELS.
- 15. THE CONTRACTOR SHALL INSURE THAT CUTTING, FITTING, PATCHING ETC. BY ALL TRADES CAUSES ALL PARTS TO COME TOGETHER PROPERLY.
- 16. TRADES SHALL FURNISH ALL LABOR, EQUIPMENT, MATERIALS AND SERVICES REQUIRED TO PERFORM ALL WORK NECESSAR INDICATED, REASONABLY INFERRED, OR REQUIRED BY ANY CODE WITH JURISDICTION TO COMPLETE THEIR SCOPE OF WORK FO A COMPLETE AND PROPERLY FINISHED JOB USING ONLY NEW MATERIALS IN ACCORDANCE WITH THE BEST ACCEPTED STANDARDS OF WORKMANSHIP. ANY ITEMS SCHEDULED TO BE FURNISHED BY THE OWNER TO BE INSTALLED BY THE CONTRACTOR.
- 17. THE CONTRACTOR SHALL HAVE A SUPERINTENDENT AT THE CONSTRUCTION SITE WHENEVER ANY WORK UNDER THIS CONTRACT IS BEING PERFORMED IN ORDER TO PROVIDE CONSTANT SUPERVISION.
- 18. THE CONTRACTOR SHALL MAINTAIN THE JOB SITE IN A NEAT AN SAFE CONDITIONS IN ACCORDANCE WITH TITLE 8 OF CONSTRUCTION SAFETY ORDERS AS ENFORCED BY THE DIVISION OF INDUSTRIAL SAFETY AT ALL TIMES THROUGHOUT THE CONSTRUCTION PERIOD. THE CONTRACTOR SHALL WEEKLY CLEAN UP, REMOVE AND DISPOSE IN A LEGAL MANNER ALL DEBRIS AND WASTE ATTRIBUTED TO THE JOB.
- 19. CONTRACTOR SHALL CHECK AND VERIFY SIZE AND LOCATION OF OPENINGS FOR VENTS, DUCTS, PLUMBING RUNS, ELECTRICAL FIXTURES, ETC. WITH PRODUCT SPECIFICATIONS AND ARCHITECTURAL DRAWINGS.
- 20. THE STABILITY AND INTEGRITY OF THE EXISTING STRUCTURE DURING CONSTRUCTION SHALL BE MAINTAINED AT LEVELS GENERALLY ACCEPTABLE WITHIN THE CONSTRUCTION INDUSTRY BY THE USE OF BRACING, SHORING, AND UNDERPINNING UN THE PROPOSED AND FUTURE STRUCTURAL MODIFICATIONS ARE COMPLETED. IN NO CASE SHALL THE STRUCTURE BE ALLOWED TO BECOME UNSAFE DURING CONSTRUCTION. THE BRACING AND SHORING SYSTEMS REQUIRED TO PROVIDE TEMPORARY SUPPORT OF THE EXISTING STRUCTURE DURING CONSTRUCTION SHALL BE DESIGNED TO SUPPORT THE DEAD, LIVE, SOIL, EARTHQUAKE AND WIND LOADS THAT MAY BE IMPOSED ON THE STRUCTURE DURING CONSTRUCTION IN ACCORDANCE WITH INDUSTRY STANDARDS AND GENERALLY ACCEPTED ENGINEERING PRINCIPALS.
- 21. CONTRACTOR SHALL PROVIDE ALL NECESSARY BLOCKING, STIFFENERS, BRACING, FRAMING, HANGERS, OR OTHER SUPPOR FOR ALL FIXTURES, EQUIPMENT, CABINETRY, FURNISHINGS AND ALL OTHER ITEMS REQUIRING THE SAME.
- 22. THE CONTRACTOR SHALL IDENTIFY CRITICAL DUE DATES FOR A) OWNER SELECTIONS TO BE PURCHASED AND INSTALLED BY THE CONTRACTOR AND B) CONTRACTOR RECEIPT OF OWNER PURCHASED ITEMS TO BE INSTALLED BY THE CONTRACTOR.
- 23. THE CONTRACTOR SHALL BE RESPONSIBLE FOR REPLACEMENT OR REPAIR OF ANY DAMAGE CAUSED BY HIM OR HIS SUBCONTRACTORS. THE CONTRACTOR SHALL BE RESPONSIBLE FOR ANY DAMAGE TO UNDERGROUND UTILITIES ENCOUNTERE IN AREAS WHERE EXCAVATIONS ARE INDICATED AND SHALL REPAIR ANY SUCH DAMAGE AT HIS/HER OWN EXPENSE.
- 24. THE CONTRACTOR SHALL GUARANTEE ALL WORKMANSHIP AND MATERIALS FOR ONE YEAR, FROM THE DATE OF COMPLETIC OF THE WORK. THE CONTRACTOR SHALL REPLACE OR REPAIR ANY DEFECTS OR FAULTY MATERIALS UNDER THE GUARANTEE
- 25. THE CONTRACTOR SHALL PROVIDE THE OWNER A LIST OF ALL FEATURES, COMPONENTS, AND MECHANICAL DEVICES, AND INSTRUCTIONS ON HOW TO USE THEM EFFICIENTLY.
- 26. ALL EXISTING CONDITIONS NOT NOTED ON THE PLANS IN THE SCOPE OF WORK ARE TO REMAIN AND SHALL BE PROTECTED. CONTRACTOR SHALL BE RESPONSIBLE FOR AND SHALL REPLACE IN KIND AT HIS/HER COST ANY ITEMS DAMAGED BY PERFORMANCE OF THE WORK.
- 27. DIMENSIONS ARE TO F.O. STUD, UNLESS NOTED OTHERWISE
- 28. SINCE ALL THE CONTRACT DOCUMENTS ARE COMPLEMENTARY TO EACH OTHER, THE CONTRACTOR IS OBLIGATED TO STUI AND COMPARE THE DRAWINGS AND OTHER CONTRACT DOCUMENTS BEFORE STARTING EACH PORTION OF WORK. ADDITIONALLY, THE CONTRACTOR IS OBLIGATED TO TAKE FIELD MEASUREMENTS AND OBSERVATIONS OF ANY CONDITIONS AFFECTING EACH PORTION OF WORK. THESE OBLIGATIONS ARE INTENDED ONLY TO FACILITATE CONSTRUCTION. IN THE EVEN OF INCONSISTENCIES, CONFLICTS, AND/OR MISSING INFORMATION BETWEEN THE CONTRACT DOCUMENTS, THE CONTRACTOR SHALL REPORT SUCH TO THE ARCHITECT IN THE FORM OF A REQUEST FOR INFORMATION PRIOR TO PROCEEDING WITH EACH PORTION OF THE WORK

ABBREVIATIONS

- @ o	ANGLE AT	CU YD DB	CUBIC YARDS DECIBEL	GYP BD GYP PLAS		MT MTD	MOUNTED MOUNTED
x	AND CHANNEL	DBL DEMO	DOUBLE DEMOLISH(ION)	HB HC	HOSE BIBB HOLLOW CORE	MTG MTL	MEETING METAL
_,	DEGREE	DET	DETAIL	HCWD	HOLLOW CORE WOOD DOOR	MULL	MULLION
М	DIAMETER MATCH LINE	DF DHW	DRINKING FOUNTAIN DOMESTIC HOT WATER	H&CW HCP	HOT AND COLD WATER HANDICAPPED	MULT MW	MULTIPLE MEGAWATT
⊢/-	PLUS OR MINUS	DIA	DIAMETER	HD	HEAVY DUTY	mW	MILLIWATT
PL AB	PROPERTY LINE ANCHOR BOLT	DIAG DIAG	DIAGONAL DIAGRAM	HDBD HDO	HARDBOARD HIGH DENSITY OVERLAY	MWP	MEMBRANE WATERPROOFING
ABV	ABOVE	DIAG	DIMENSION	HDR	HEADER	N	NEW
\/C	AIR CONDITIONING	DIR	DIRECTION	HDWD	HARDWOOD	(N)	NEW
AC A.C.T.	ACOUSTIC ACOUSTIC CEILING TILE	DISP DIST	DISPENSER DISTANCE	HDW HM	HARDWARE HOLLOW METAL	NA NCOMBL	NOT APPLICABLE NONCOMBUSTIBLE
A.C.T. ACST	ACOUSTIC CEILING TILE ACOUSTIC	DMPF	DAMP PROOFING	HMD	HOLLOW METAL DOOR	NFC	NATIONAL FIRE CODE
A.D.A.	AMERICANS W/ DISABIL. ACT	DN	DOWN	HMDF	HOLLOW METAL DOOR AND	NIC	NOT IN CONTRACT
ADMIN	ADDENDUM ADMINISTRATION	DOZ DR	DOZEN DOOR OR DRAIN	HMF	FRAME HOLLOW METAL FRAME	NLB NO	NON LOAD BEARING NUMBER
ADJ	ADJUSTABLE	DR CL	DOOR CLOSER	HOR	HORIZONTAL	NOC	NOTICE OF CLARIFICATION
λE	ARTISTIC ELEMENT	DR FR	DOOR FRAME	HSKPG	HOUSEKEEPING	NOM	NOMINAL
∖FF ∖HU	ABOVE FINISHED FLOOR AIR HANDLING UNIT	DRW DW	DRAWER DISH WASHER	HT HVAC	HEIGHT HEATING/VENTILATING/AIR	NONFLMB NRS	NONFLAMMABLE NOISE REDUCTION
AISC	AMERICAN INSTITUTE OF	DW	DOMESTIC WATER	TIVAC	CONDITIONING	MINO	COEFFICIENT
	STEEL CONSTRUCTION	DWH	DOMESTIC WATER HEATER	HW	HOT WATER	NTS	NOT TO SCALE
ALLOW ALT	ALLOWANCE ALTERNATE	DWR DWH	DOMESTIC WATER RETURN DOMESTIC WATER SUPPLY	HYD HYDR	HYDRANT HYDRAULIC HZ HERTZ	O/ OA	OVER OUTSIDE AIR OR OVERALL
ALUM	ALUMINUM	DWG	DRAWING	IBC	INTERNATIONAL BUILDING	OBS	OBSCURED
ANC	ANCHOR(AGE)	E	EXISTING		CODE	OC	ON CENTER
ANOD AP	ANODIZED ACCESS PANEL	(E) EA	EXISTING EACH	ID	INSIDE DIAMETER OR INTERIOR DESIGN(ER)	OD OF	OUTSIDE DIAMETER OUTSIDE FACE
NPA	AMERICAN PLYWOOD	EDF	ELECTRIC DRINKING FOUNTAIN	IFS	INSIDE FACE OF STUD	OFCI	OWNER FURNISHED/
	ASSOCIATION	EFS	EXTERIOR FINISH SYSTEM	ILLUM	ILLUMINATION	055	CONTRACTOR INSTALLED
APPROX ARCH	APPROXIMATE ARCHITECT(URAL)	EGB EGSB	EXTERIOR GYPSUM BOARD EXTERIOR GYPSUM	INCL INSUL	INCLUDE(ING) INSULATION	OFD OFF	OVERFLOW DRAIN OFFICE
ASTM	AMERICAN SOCIETY FOR	LGOD	SHEATHING BOARD	INSUL PNL	INSULATED METAL PANEL	OFS	OUTSIDE FACE OF STUDS
	TESTING AND	EIFS	EXTERIOR INSULATION	INT	INTERIOR	ОН	OVERHEAD
ASHRAE	MATERIALS AMERICAN SOCIETY OF	EJ	AND FINISH SYSTEM EXPANSION JOINT	INTM IR	INTERMEDIATE INSIDE RADIUS	OH DR O/O	OVERHEAD DOOR (COILING) OUT TO OUT
OI II IAE	HEATING,	EJ EL	ELEVATION (HEIGHT)	IS	INSECT SCREEN	OPNG	OPENING
	REFRIGERATION AND AIR	ELEV	ELEVATOR	JAN	JANITOR	OPH	OPPOSITE HAND
	CONDITIONING ENGINEERS	ELEC ENCL	ELECTRIC(AL) ENCLOSURE	JAN CL J-BOX	JANITOR CLOSET JUNCTION BOX	OPP OPR	OPPOSITE OPERABLE
ASME	AMERICAN SOCIETY	ENCL	ENTRANCE	J-BOX	JOINT	OPR	OPTIONAL
	OF MECHANICAL	EP	ELECTRICAL PANEL	K	THOUSAND	ORD	OVERFLOW ROOF DRAIN OR
ATT'MT	ENGINEERS ATTACHMENT	EQ EQUIP	EQUAL EQUIPMENT	K VALUE kHZ	THERMAL CONDUCTIVITY KILOHERTZ	ORIG	ORDINANCE ORIGINAL
ATTN	ATTACHMENT	EQUIV	EQUIVALENT	KIT	KITCHEN	OR	OUTSIDE RADIUS
AUTO	AUTOMATIC	ESCAL	ESCALATOR	KIT	KITCHEN	ORN	ORNAMENTAL
AN YUX	AUXILIARY AUDIO/VISUAL	EST EXH	ESTIMATE EXHAUST	KO KPL	KNOCKOUT KICKPLATE	OSB OZ	ORIENTED STRAND BOARD OUNCE
AVE	AVENUE	EXIST	EXISTING	KSF	KIPS PER SQUARE FOOT	P	POLE
AVG	AVERAGE	EXIST'G	EXISTING	KSI	KIPS PER SQUARE INCH	PAR	PARALLEL OR PARAPET
3/B 3C	BACK TO BACK BOTTOM CHORD	EXP EXST GR	EXPOSED OR EXPANSION EXISTING GRADE	KW LAB	KILOWATT LABORATORY	PBD PC	PARTICLE BOARD PORTLAND CEMENT
3D	BOARD	EXT	EXISTING GRADE EXTERIOR OR	LAD	LAMINATE	PCC	PRECAST CONCRETE
3FF	BELOW FINISH FLOOR		EXTINGUISHER	LAM GL	LAMINATED GLASS	PCF	POUNDS PR CUBIC FEET
BITUM BKG	BITUMINOUS BACKING	EXT GR FA	EXTERIOR GRADE FIRE ALARM	LAM PL LAV	LAMINATED PLASTIC LAVATORY	PCI	RECAST/PRESTRESSED CONCRETE INSTITUTE
BKG BL	BASE LINE	FAR	FLOOR AREA RATIO	LAV	POUNDS	PCP	PORTLAND CEMENT PLASTER
BLDG	BUILDING	FC	FOOT CANDLE	LC	LAUNDRY CHUTE	PERIM	PERIMETER
BLKG BLW CLG	BLOCKING BELOW CEILING	FCU FD	FAN COIL UNIT	LCD LCMU	LINEAR CEILING DIFFUSER LIGHTWEIGHT CONCRETE	PERM PERP	PERMANENT PERPENDICULAR
BLW CLG BM	BEAM	FDC	FLOOR DRAIN FIRE DEPT CONNECTION	LUIVIU	MASONRY UNIT	PHWS	PHILLIPS HEAD WOOD SCRE
BOT	BOTTOM	FDR	FIRE DOOR	LD	LINEAR DIFFUSER LF LINEAR FT	PI	POINT OF INTERSECTION
BOH BPL	BACK OF HOUSE BASE PLATE	FDTN FE	FOUNDATION FIRE EXTINGUISHER	LH LHR	LEFT HAND LEFT HAND REVERSE	PIL PK GAR	PILASTER PARKING GARAGE
BRK	BRICK	FEC	FIRE EXTINGUISHER CABINET	LIB	LIBRARY	PK LOT	PARKING LOT
BRZ	BRONZE	FF EL	FINISH FLOOR ELEVATION	LIN	LINEAR	PL	PROPERTY LINE
BW BYND	BOTH WAYS BEYOND	FF FF&E	FACE OF FINISH FURNITURE, FIXTURES, AND	LMST LP	LIMESTONE LIGHT POLE	PLAS PLAM	PLASTER OR PLASTIC PLASTIC LAMINATE
C TO C	CENTER TO CENTER	ΓΓαΕ	EQUIPMENT	LL	LANDLORD	PLBG	PLUMBING
C VALUE	THERMAL CONDUCTANCE	FG	FIXED GLASS	LPW	LUMENS PER WATT	PLYWD	PLYWOOD
CAB CATW	CABINET CATWALK	FH FHC	FIRE HYDRANT FIRE HOSE CABINET	LT LT WT	LIGHT LIGHTWEIGHT	PNL POL	PANEL POLISHED
CD	CONSTRUCTION DOCUMENTS	FHWS	FLAT HEAD WOOD SCREW	LTC	LIGHTWEIGHT CONCRETE	PPGL	POLISHED PLATE GLASS
CD	CONTRACT DOCUMENTS	FIN	FINISH(ED)	LTG	LIGHTING	PR.	PAIR
CER CF	CERAMIC CONTRACTOR FURNISHED	FIN BS FIX	FINISH BOTH SIDES FIXTURE	LTG PNL LV	LIGHTING PANEL LOW VOLTAGE	PRKG PREFAB	PARKING PREFABRICATED
OFE	CONTRACTOR FURNISHED	FIX FLASH	FLASHING	LVR	LOUVER(ED)	PSF	POUNDS PER SQUARE FOOT
	EQUIPMENT	FL	FLOOR	LWIC	LIGHTWÈIGHT	PSI	POUNDS PER SQUARE INCH
CF/CI	CONTRACTOR FURNISHED/ CONTRACTOR INSTALLED	FLO FLR	FLUORESCENT FLOOR	LS	INSULATING CONCRETE LAG SCREW	PSL PT	PARALLEL STRAND LUMBER PRESSURE TREATED OR PAINT
CF/OI	CONTRACTOR INSTALLED CONTRACTOR FURNISHED/	FLR FO	FLOOR FINISHED OPENING	M	METER	PT CONC	POST TENSIONED CONCRETE
	OWNER INSTALLED	FOC	FACE OF CONCRETE	MAHOG	MAHOGANY	PTN	PARTITION
CHFR CHW	CHAMFER CHILLED WATER	FOF FOS	FACE OF FINISH FACE OF STUD	MAINT MATL	MAINTENANCE MATERIAL	PUR REQ'D	PURLINS REQUIRED
CHWR	CHILLED WATER CHILLED WATER RETURN	FOS FOUNT	FOUNTAIN	MAX	MAXIMUM	REFL.	REFLECTED
CHWS	CHILLED WATER SUPPLY	FOW	FACE OF WALL	MC	MECHANICAL	RM	ROOM
CIP CIR	CAST IN PLACE CIRCLE	FP FR	FIRE PROOF FIRE RATING	MB	CONTRACTOR MACHINE BOLT	SA SAWPM	SELF ADHERED SELF ADHERED WP MEMBRAN
CJ	CONSTRUCTION JOINT	FRG	FIBER REINFORCED GYPSUM	MC	METAL CLAD	SCHED	SCHEDULED
CJ	CONTROL JOINT	FRP	FIBERGLASS REINFORCED	MD	METAL DECK	SECT.	SECTION
CKT CL	CIRCUIT CENTER LINE	FS	PLASTIC FACE OF STUD	MDO ME	MEDIUM DENSITY OVERLAY MECHANICAL ENGINEER	SHT'G SIM	SHEATING SIMILAR
<u>-</u>	CENTER LINE	FT	FOOT/FEET	MECH	MECHANICAL	SMS	SHEET METAL SCREW
CLG	CEILING	FTG	FOOTING	MECH RM		STL	STEEL
CLG DIF CLG HT	CEILING DIFFUSER CEILING HEIGHT	FURN FURG	FURNITURE/FURNISHING FURRING	MED METD	MEDIUM METAL DOOR	STRUCT. SAD	STRUCTURE SEE ARCHITECTURAL DWG'S
CLK	CAULK(ING)	FURG FV	FIELD VERIFY	METF	METAL FLASHING	SCD	SEE CIVIL DRAWINGS
CLL	COLUMN LÍNE	FWC	FABRIC WALL COVERING	MEZZ	MEZZANINE	SED	SEE ELECTRICAL DRAWINGS
CLO	CONTRACT LIMIT LINE CLOSET	GA GALV	GAUGE GALVANIZED	MF MFR	MILL FINISH MANUFACTURER	SID SLD	SEE INTERIOR DRAWINGS SEE LANDSCAPE DRAWINGS
CLR	CLEAR	GALV GB.	GALVANIZED GRAB BAR	MFR REC	MANUFACTURER'S	SMD	SEE MECHANICAL DRAWINGS
COL	COLUMN	GC	GENERAL CONTRACTOR		RECOMMENDATION	SMS	SHEET METAL SCREW
CMU CONC	CONCRETE MASONRY UNIT CONCRETE	GFRC	GLASS FIBER REINFORCED CONCRETE	MH MHZ	MANHOLE MEGAHERTZ	SPD SSD	SEE PLUMBING DRAWINGS SEE STRUCTURAL DRAWINGS
CONF	CONFERENCE	GFRG	GLASS FIBER REINFORCED	MIC	MICROPHONE	SSD ST STL	STAINLESS STEEL
CONN	CONNECTION		GYPSUM	MLWK	MILLWORK	STL	STEEL
CONSTR	CONSTRUCTION CONSULTANT	GFRP	GLASS FIBER REINFORCED	MIN MIRR	MINIMUM MIRROR	SUSP.	SUSPENDED
CONT	CONTINUOUS CONTRACTOR	GL	PLASTER GLASS	MISC	MISCELLANEOUS	TEMP TH	TEMPORARY THICK
CO'ORD	COORDINATE	GL BM	GLU LAM BEAM	MLDG	MOULDING	TYP	TYPICAL
CORR	CORRIDOR	GLZ	GLAZING CDOUND FLOOR	ML&P	METAL LATH AND PLASTER	T.B.D.	TO BE DETERMINED
CPT	CARPET CLOSET ROD	GR FL GR LN	GROUND FLOOR GRADE LINE	MM MO	MILLIMETER MASONRY OPENING	T & G U.N.O.	TONGUE & GROOVE UNLESS NOTED OTHERWISE
;R	CAST STONE	GR LIV GSB	GYPSUM SHEATHING	MR	MOISTURE RESISTANT	V.C.T.	VINYL COMPOSITION TILE
CR CS	CASISIONE	0.00		MRB	MARBLE BASE	VERT	VERTICAL
	CERAMIC TILE CENTER	GWT	BOARD GLAZED WALL TILE	MRF	MARBLE FLOOR	V.I.F.	VERIFY IN FIELD

SYMBOLS & LEGEND

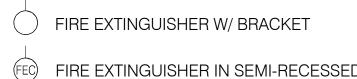

CABINET




CASEWORK

(A999) EQUIPMENT

REVISION

(W999) WASHROOM EQUIPMENT




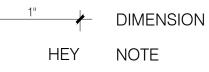

BREAK LINE

DOOR

WINDOW

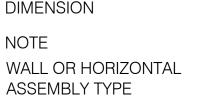

CLEARANCES & CONFIGURATION REQUIRED FOR ADA ACCESS COMPLIANCE ARE INDICATED AS FOLLOWS & REFER TO DETAILS ON SHEETS T1.3A & T1.3A:

INDICATES REQ'D-CLEARANCE INDICATES DETAIL-SCHEDULED FIXTURE (SAME FOR DOOR, EQUP., ETC)



FLUID STUDIOS LLP PO BOX 167 FOREST KNOLLS CA 94933

PROJECT SPONSOR Station House Cafe attn: Sheryl Cahill 11285 CA-1 Pt. Reyes Station CA 94956 cell: (707) 477-5496 email: sheryl@stationhousecafe.com

WHERE OCCURS WITHOUT WATER PROOF

POUND

ARCHITECT Fluid Studios, LLP Attn: Andrew Davis PO Box 167 Forest Knolls, CA 94933 415.250.1855 REN. 09-30-21 andrew@fluid-studios.com

/1\ 2021.04.16 - USE PERMIT COMMENTS

11285 CA-1 PT REYES STATION CA 94952 APN 119-226-01

TENANT IMPROVEMENTS


NOT FOR CONSTRUCTION


SCALE: NTS

GENERAL CONDITIONS,

LEGEND & SYMBOLS

SHEET

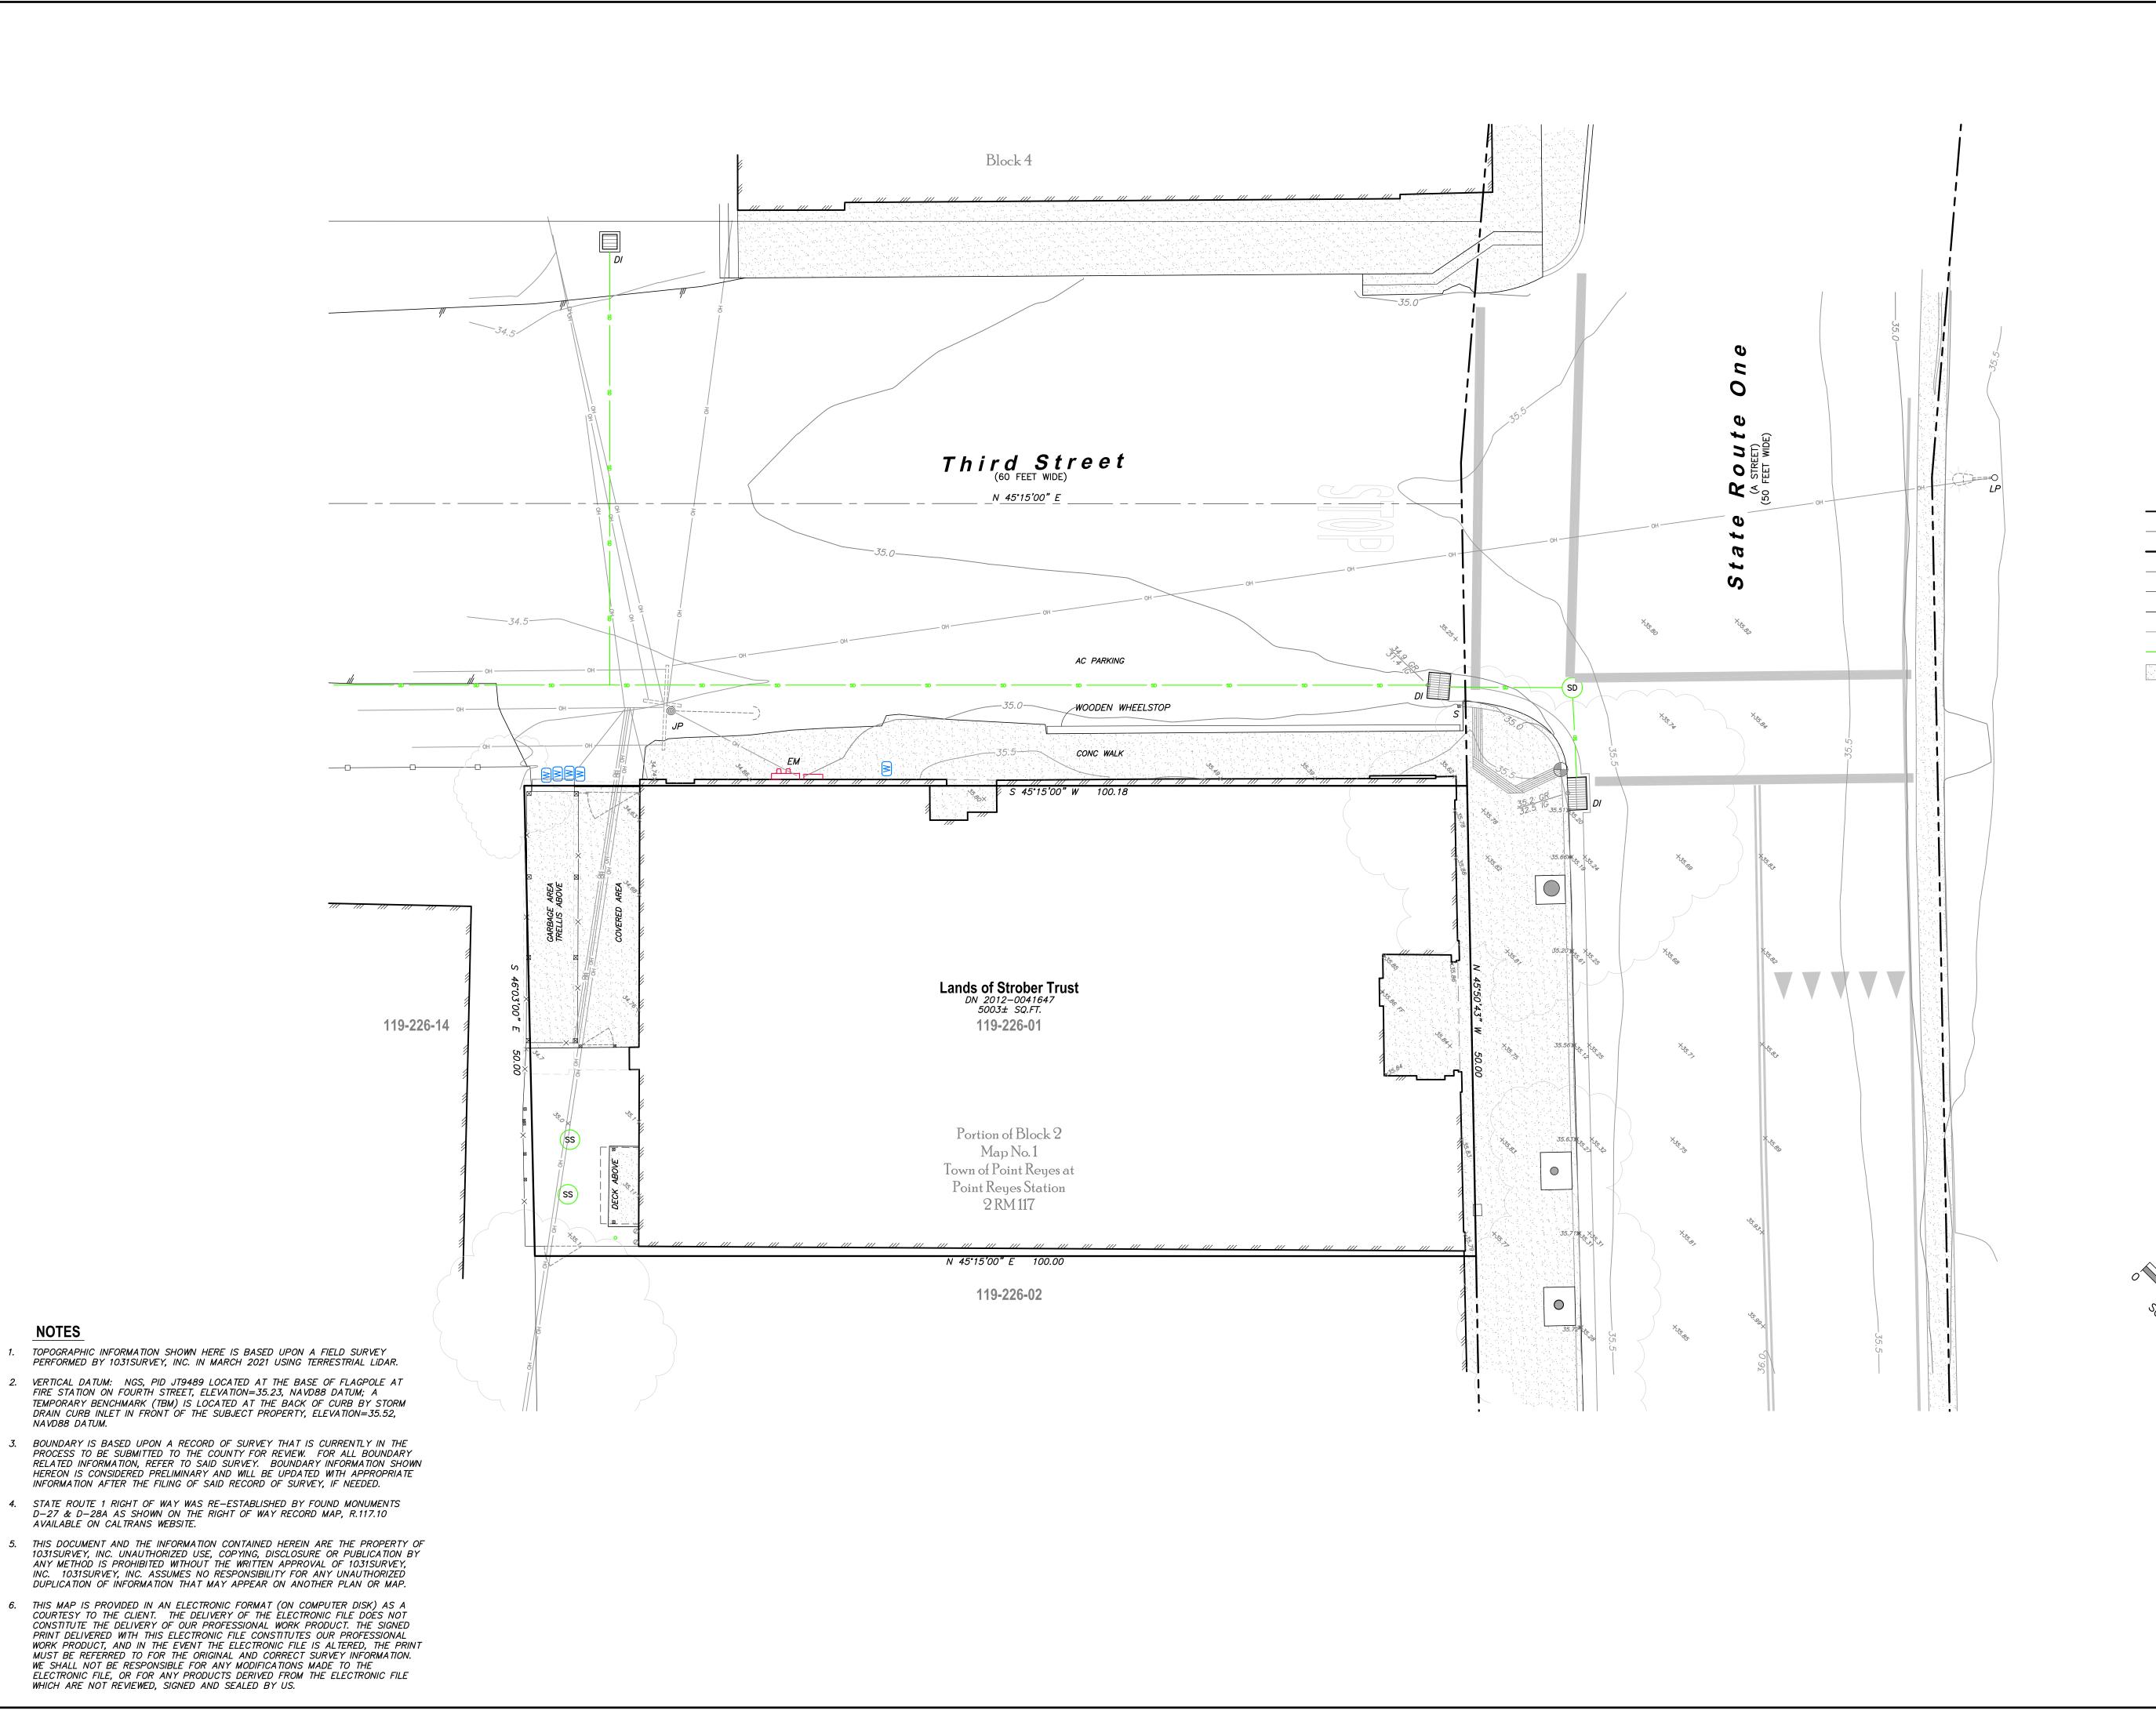

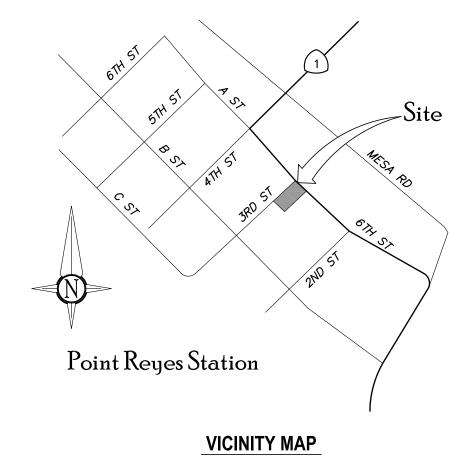

LEGEND

BUILDING

CENTERLINE PER MAP

STATE RIGHT OF WAY

FENCE, WOOD PICKET

FENCE, WOOD SOLID

EDGE OF PAVEMENT

OVERHEAD UTILITIES

STORM DRAIN

CONCRETE

DROP INLET

ELECTRIC MAIN


GUY ANCHOR

TEMPORARY BENCHMARK

WATER METER

ABBREVIATIONS

APN ASSESSORS PARCEL NUMBER
AC ASPHALTIC CONCRETE
CONC CONCRETE
DI DROP INLET
EM ELECTRIC METER
FF FINISHED FLOOR
GR GRATE
IG INVERT GRADE
JP JOINT POLE
LP LIGHT POLE
MCR MARIN COUNTY RECORDS
OH OVERHEAD UTILITY LINES
NTS NOT TO SCALE
S SIGN
SD STORM DRAIN
SS SANITARY SEWER, SEPTIC TANK
TBM TEMPORARY BENCHMARK
W WATER

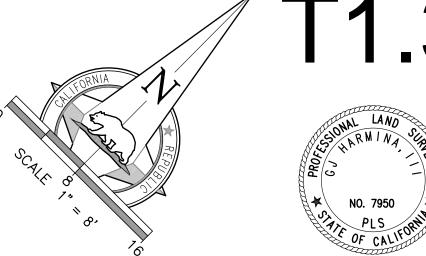

LANDS OF STROBER TRUST 11285 STATE ROUTE ONE APN 119-226-01 POINT REYES STATION, MARIN COUNTY, CALIFORNIA


Topographic Map

1031Survey, Inc.
HIGH DEFINITION SURVEYING


1857 Rainier Circle, Petaluma, California 94954 415-827-6370 www.1031survey.com

DATE: 2020.04.02 SCALE: 1" = 8' FILE: 21306Topo

SURVEY DATE: MAR2021
SHEET: 1 OF 1

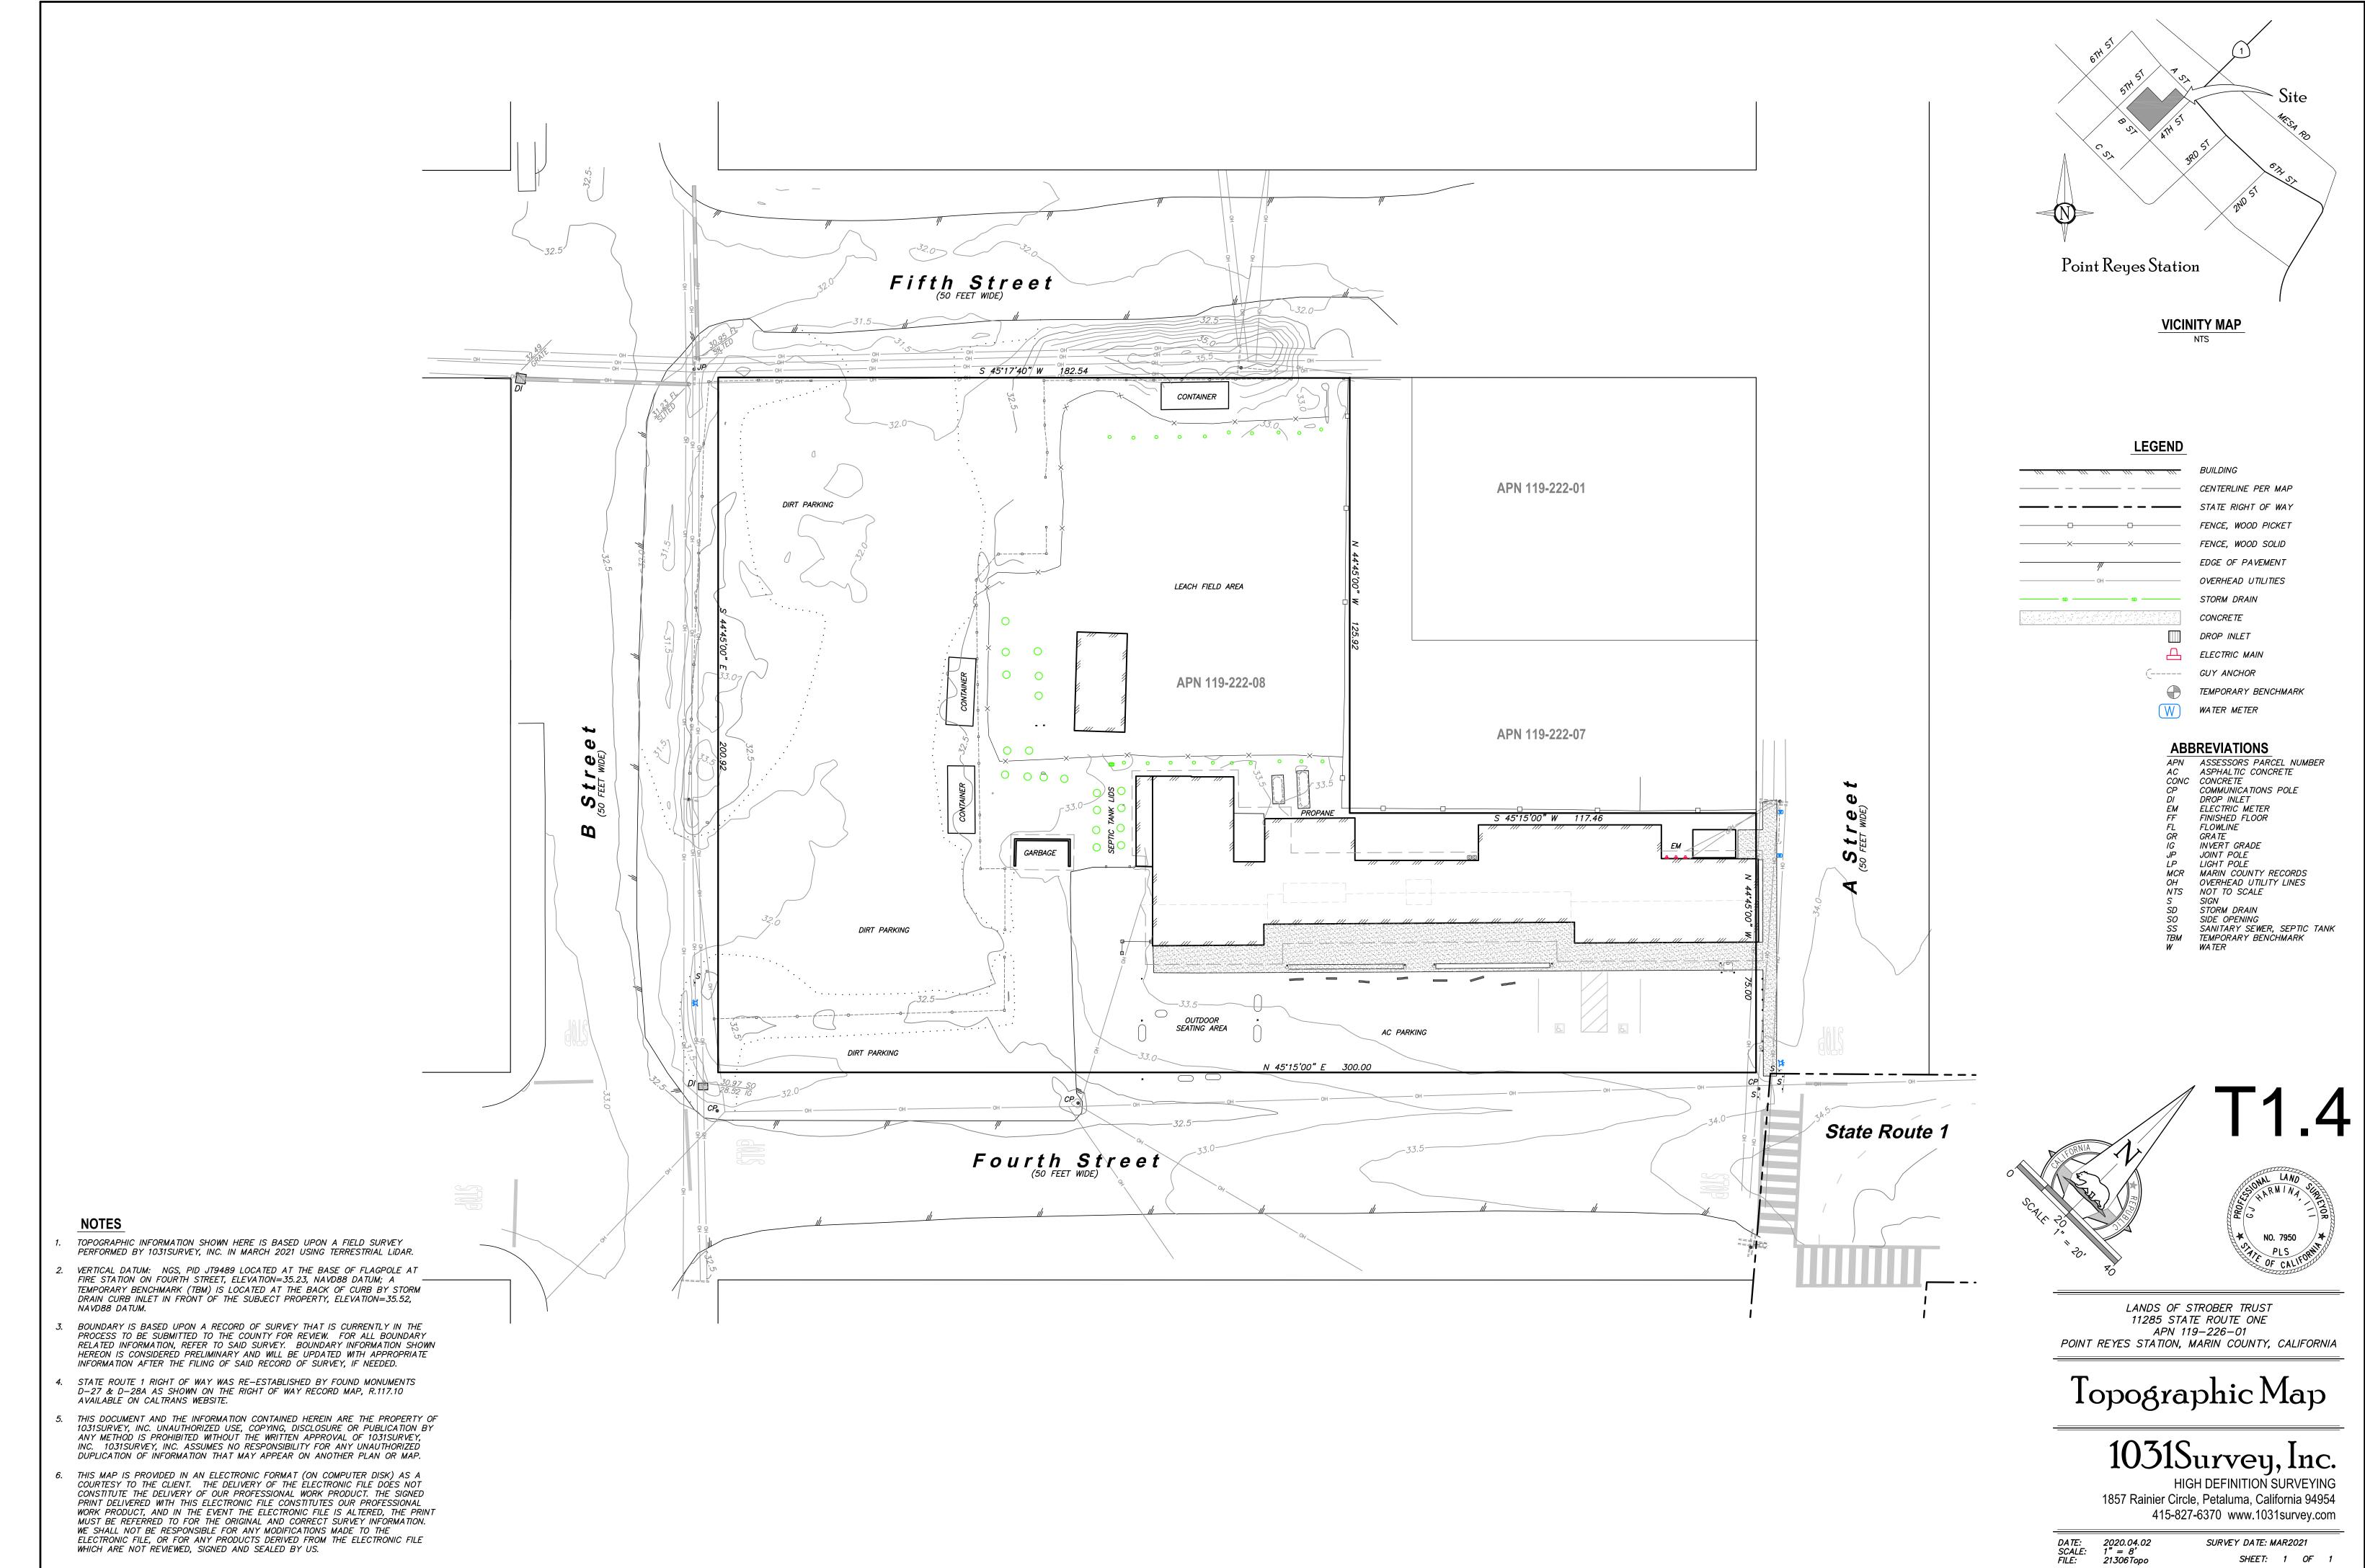

SHEET: 1 OF 1

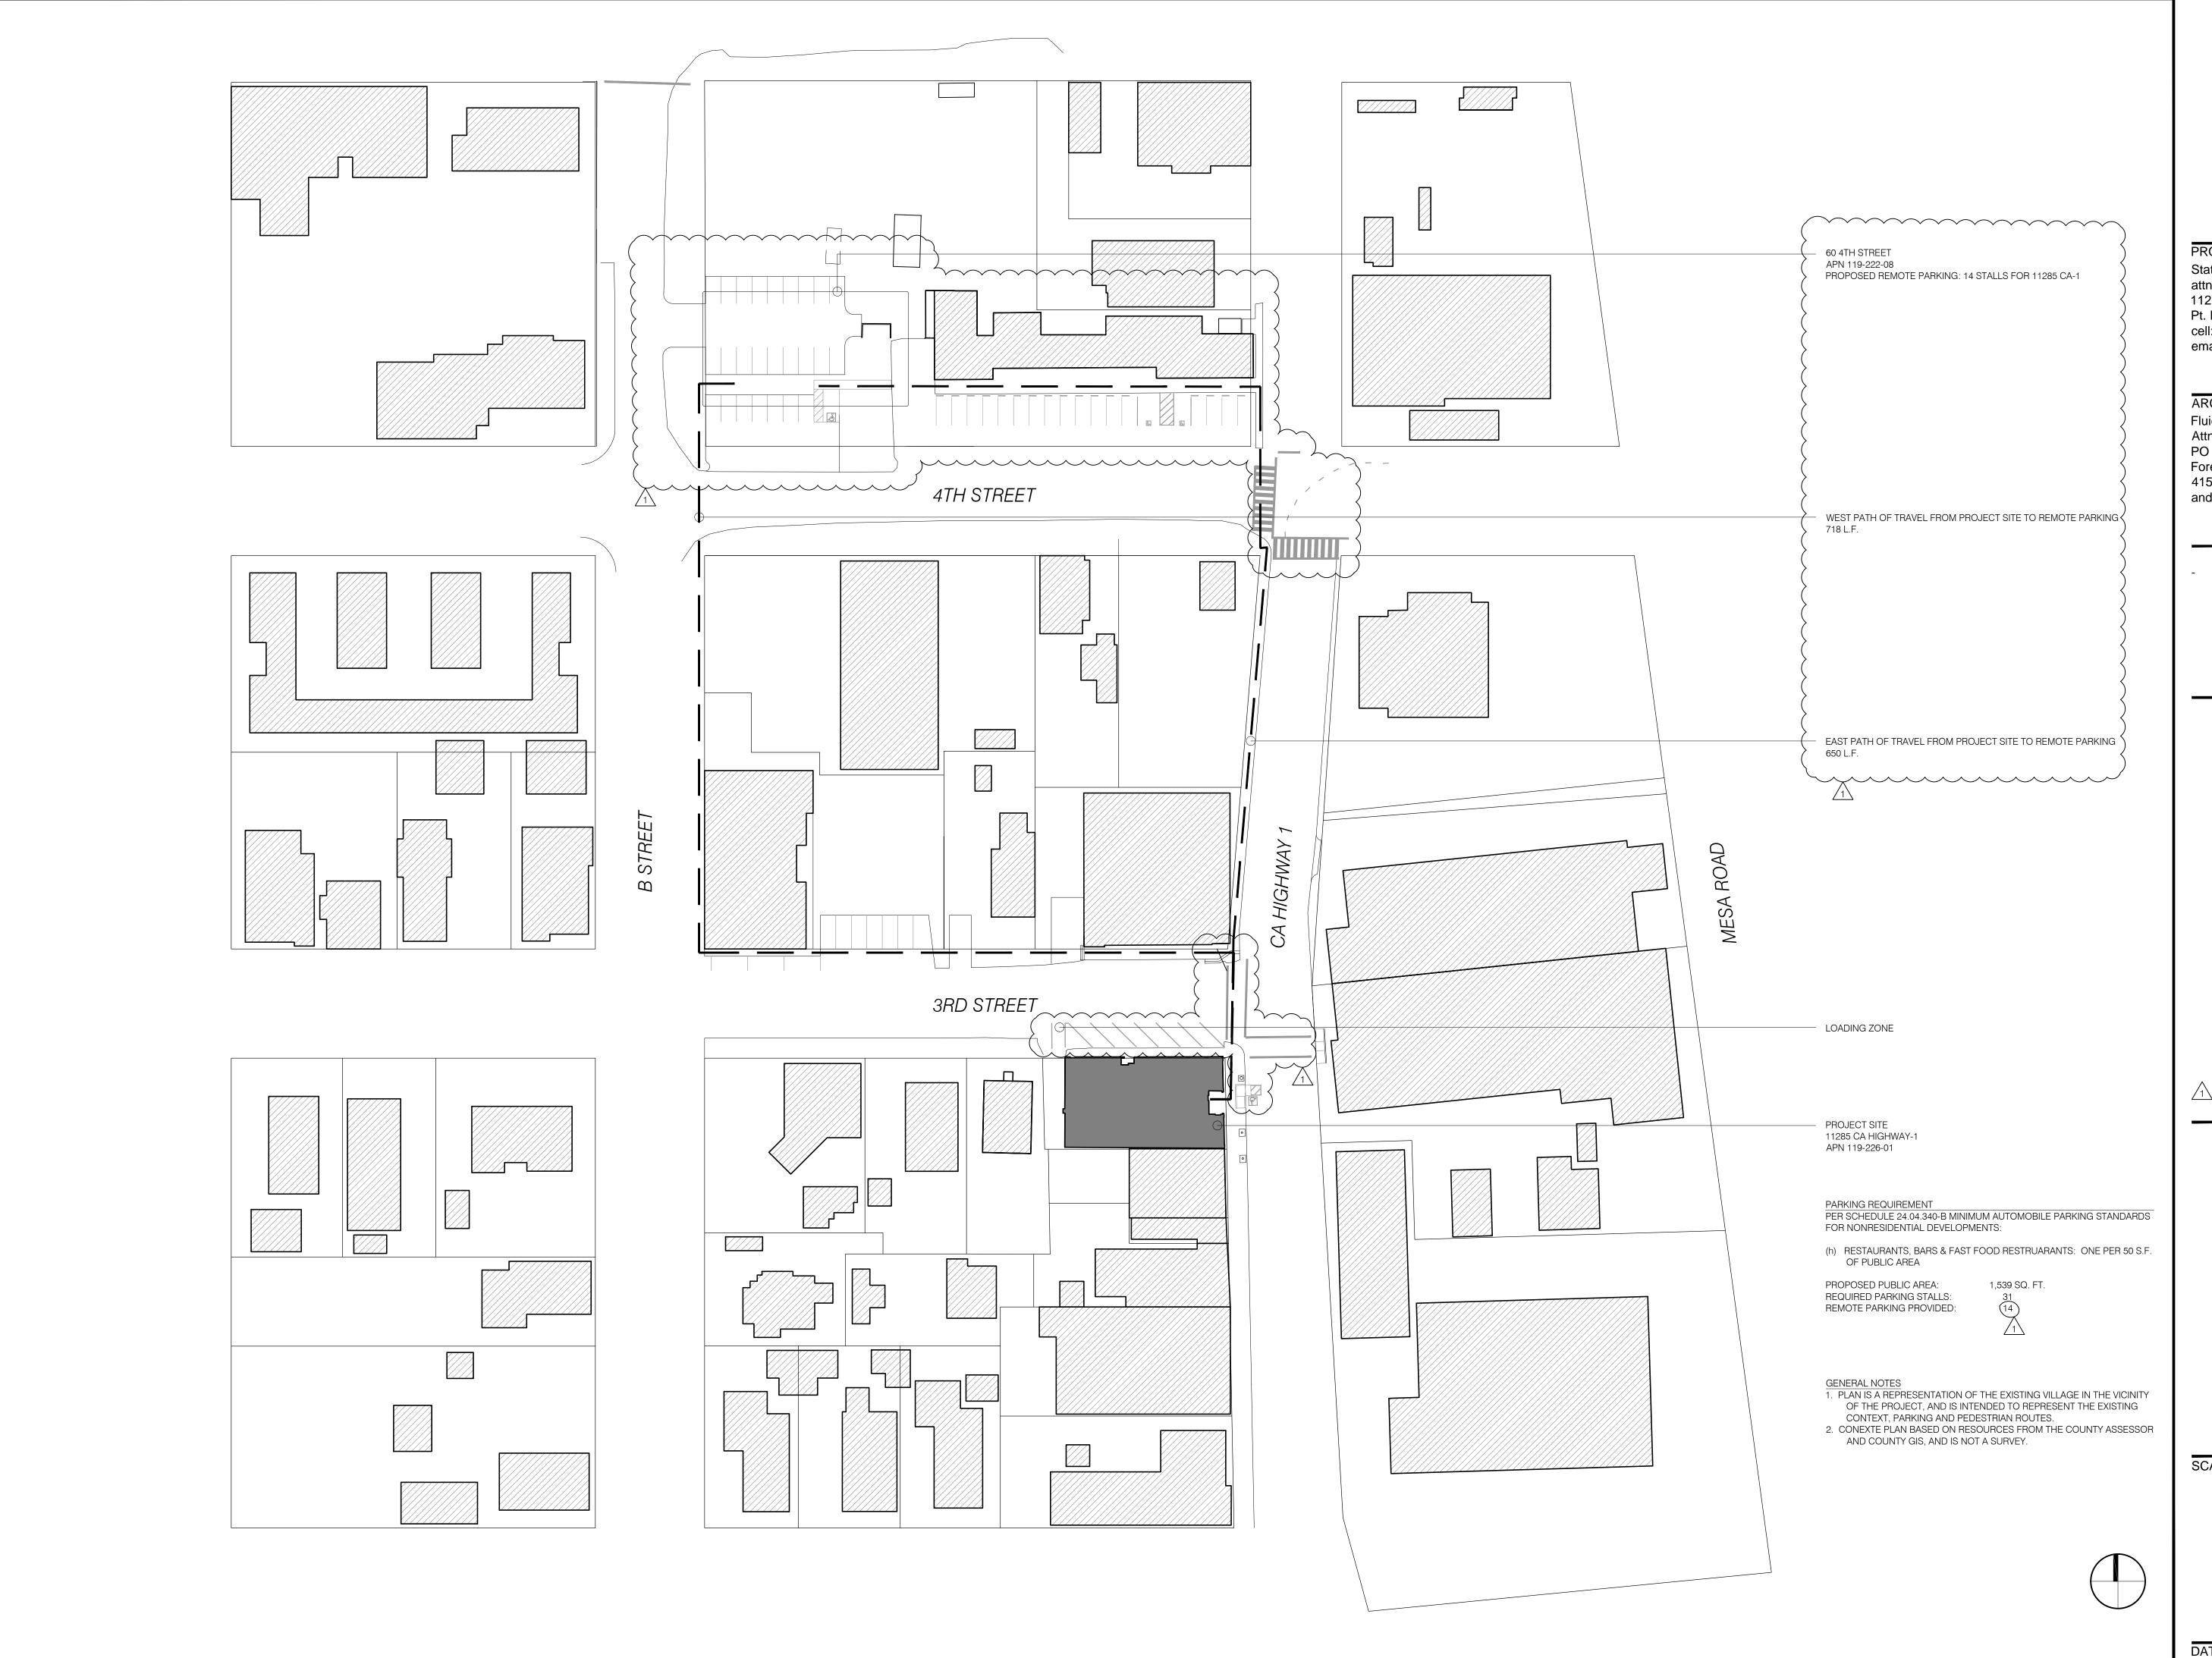



FLUID STUDIOS LLP PO BOX 167 FOREST KNOLLS CA 94933

REN. 09-30-21

PROJECT SPONSOR Station House Cafe attn: Sheryl Cahill 11285 CA-1 Pt. Reyes Station CA 94956 cell: (707) 477-5496 email: sheryl@stationhousecafe.com

ARCHITECT Fluid Studios, LLP Attn: Andrew Davis PO Box 167 Forest Knolls, CA 94933 415.250.1855 andrew@fluid-studios.com

2021.04.16 - USE PERMIT COMMENTS


11285 CA-1 PT REYES STATION CA 94952 APN 119-226-01


> **TENANT IMPROVEMENTS**

NOT FOR CONSTRUCTION


SCALE: 1" = 40'-0"

CONTEXT PLAN

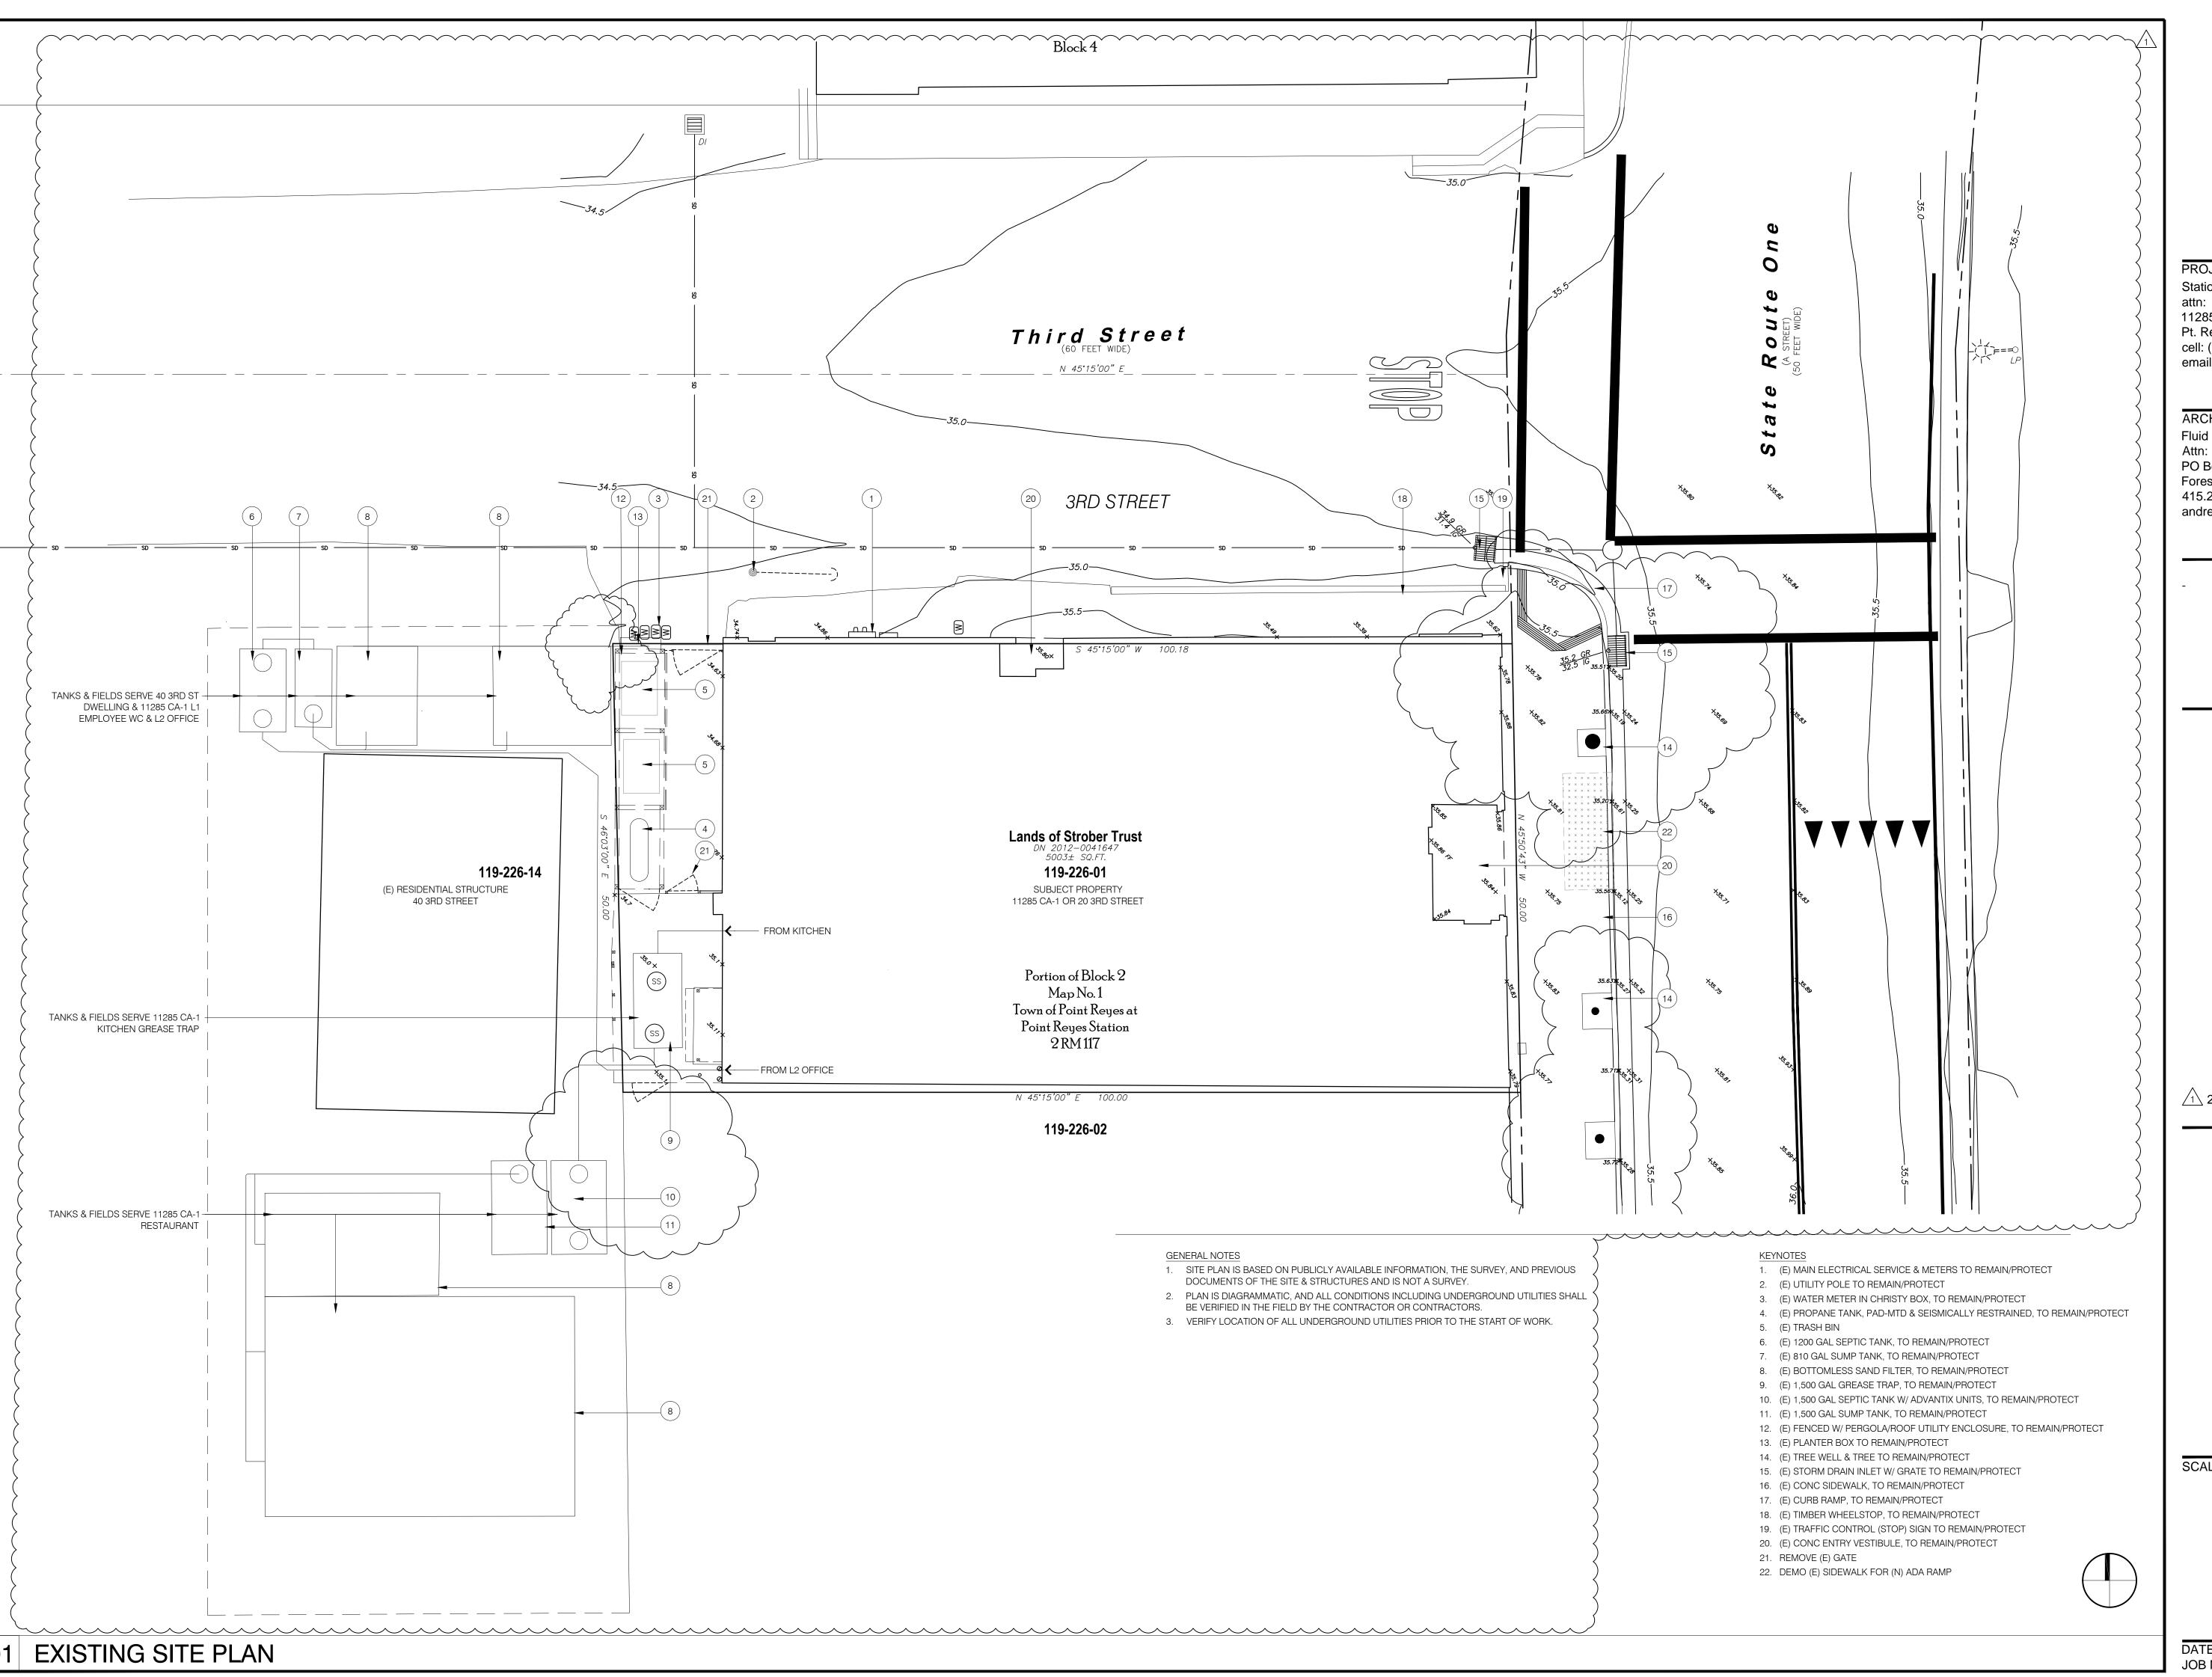

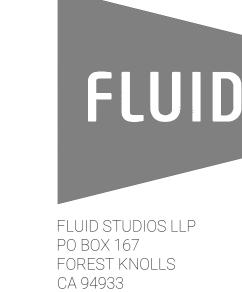

ARCHITECT
Fluid Studios, LLP
Attn: Andrew Davis
PO Box 167
Forest Knolls, CA 94933
415.250.1855
andrew@fluid-studios.com

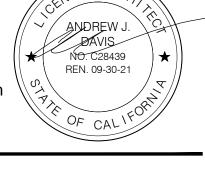

1 2021.04.16 - USE PERMIT COMMENTS

11285 CA-1
PT REYES STATION
CA 94952
APN 119-226-01

TENANT IMPROVEMENTS


NOT FOR CONSTRUCTION


SCALE: 1/8" = 1'-0"


- 1 0


EXISTING SITE PLAN

T2.2

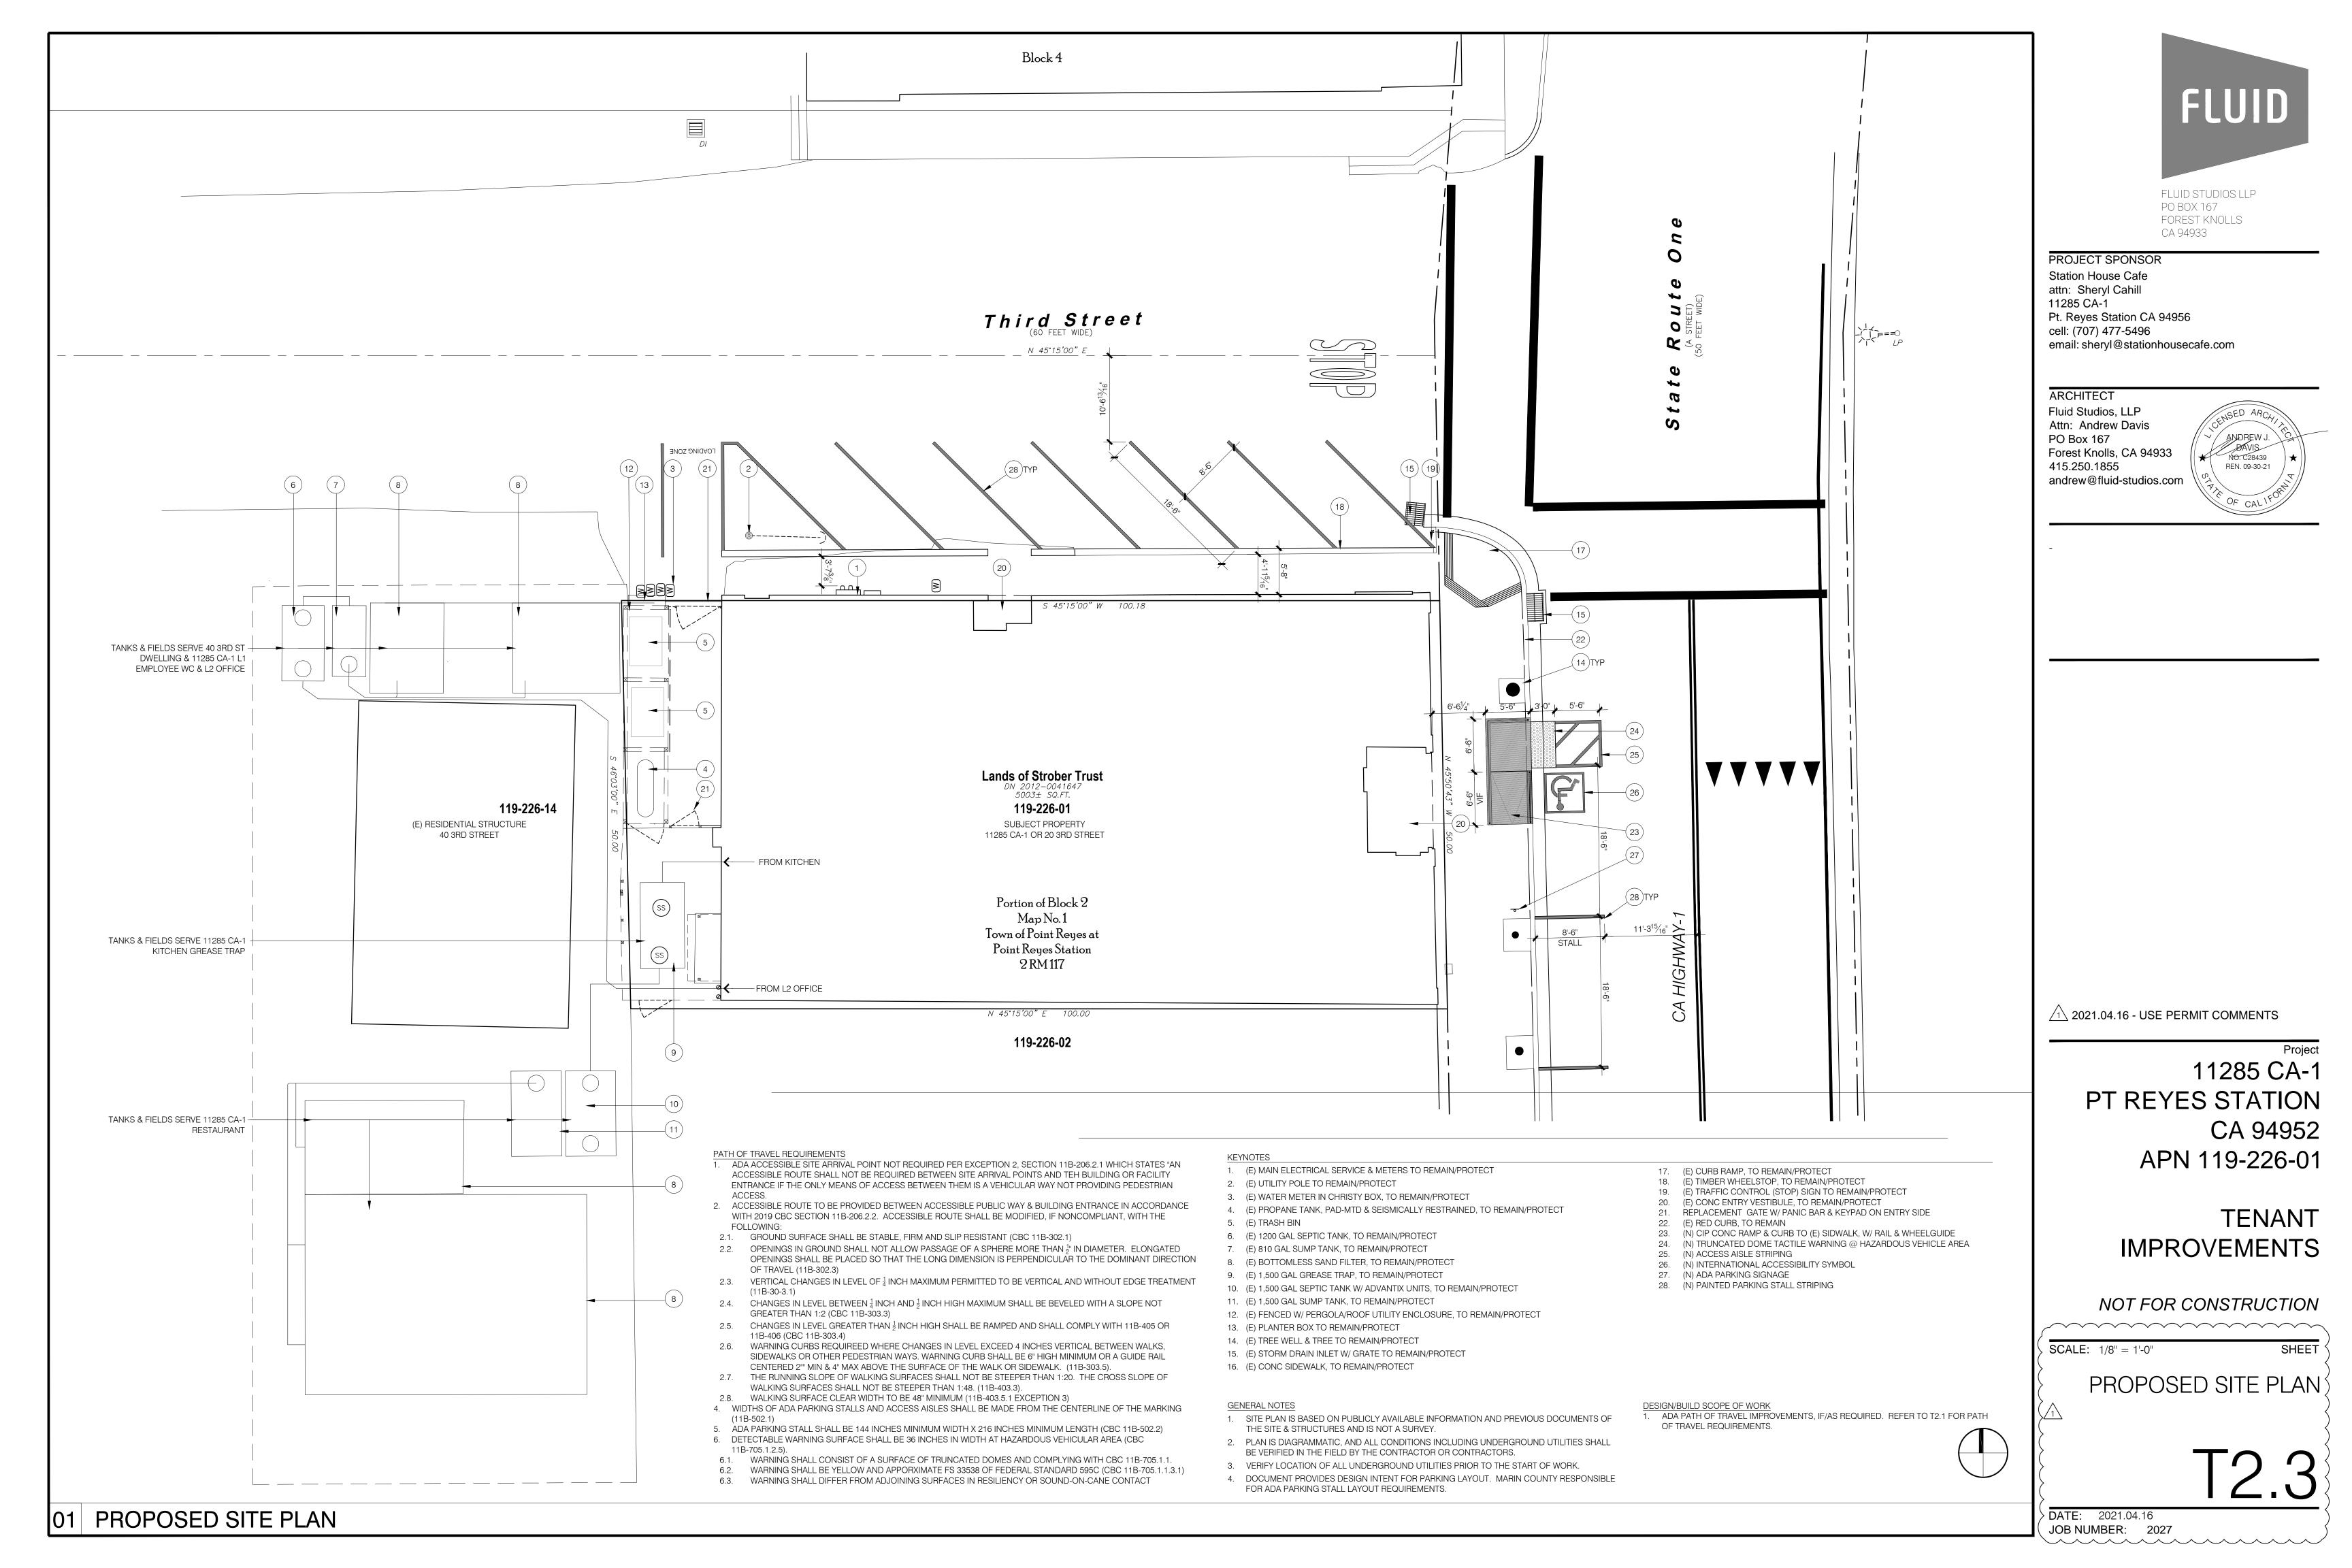

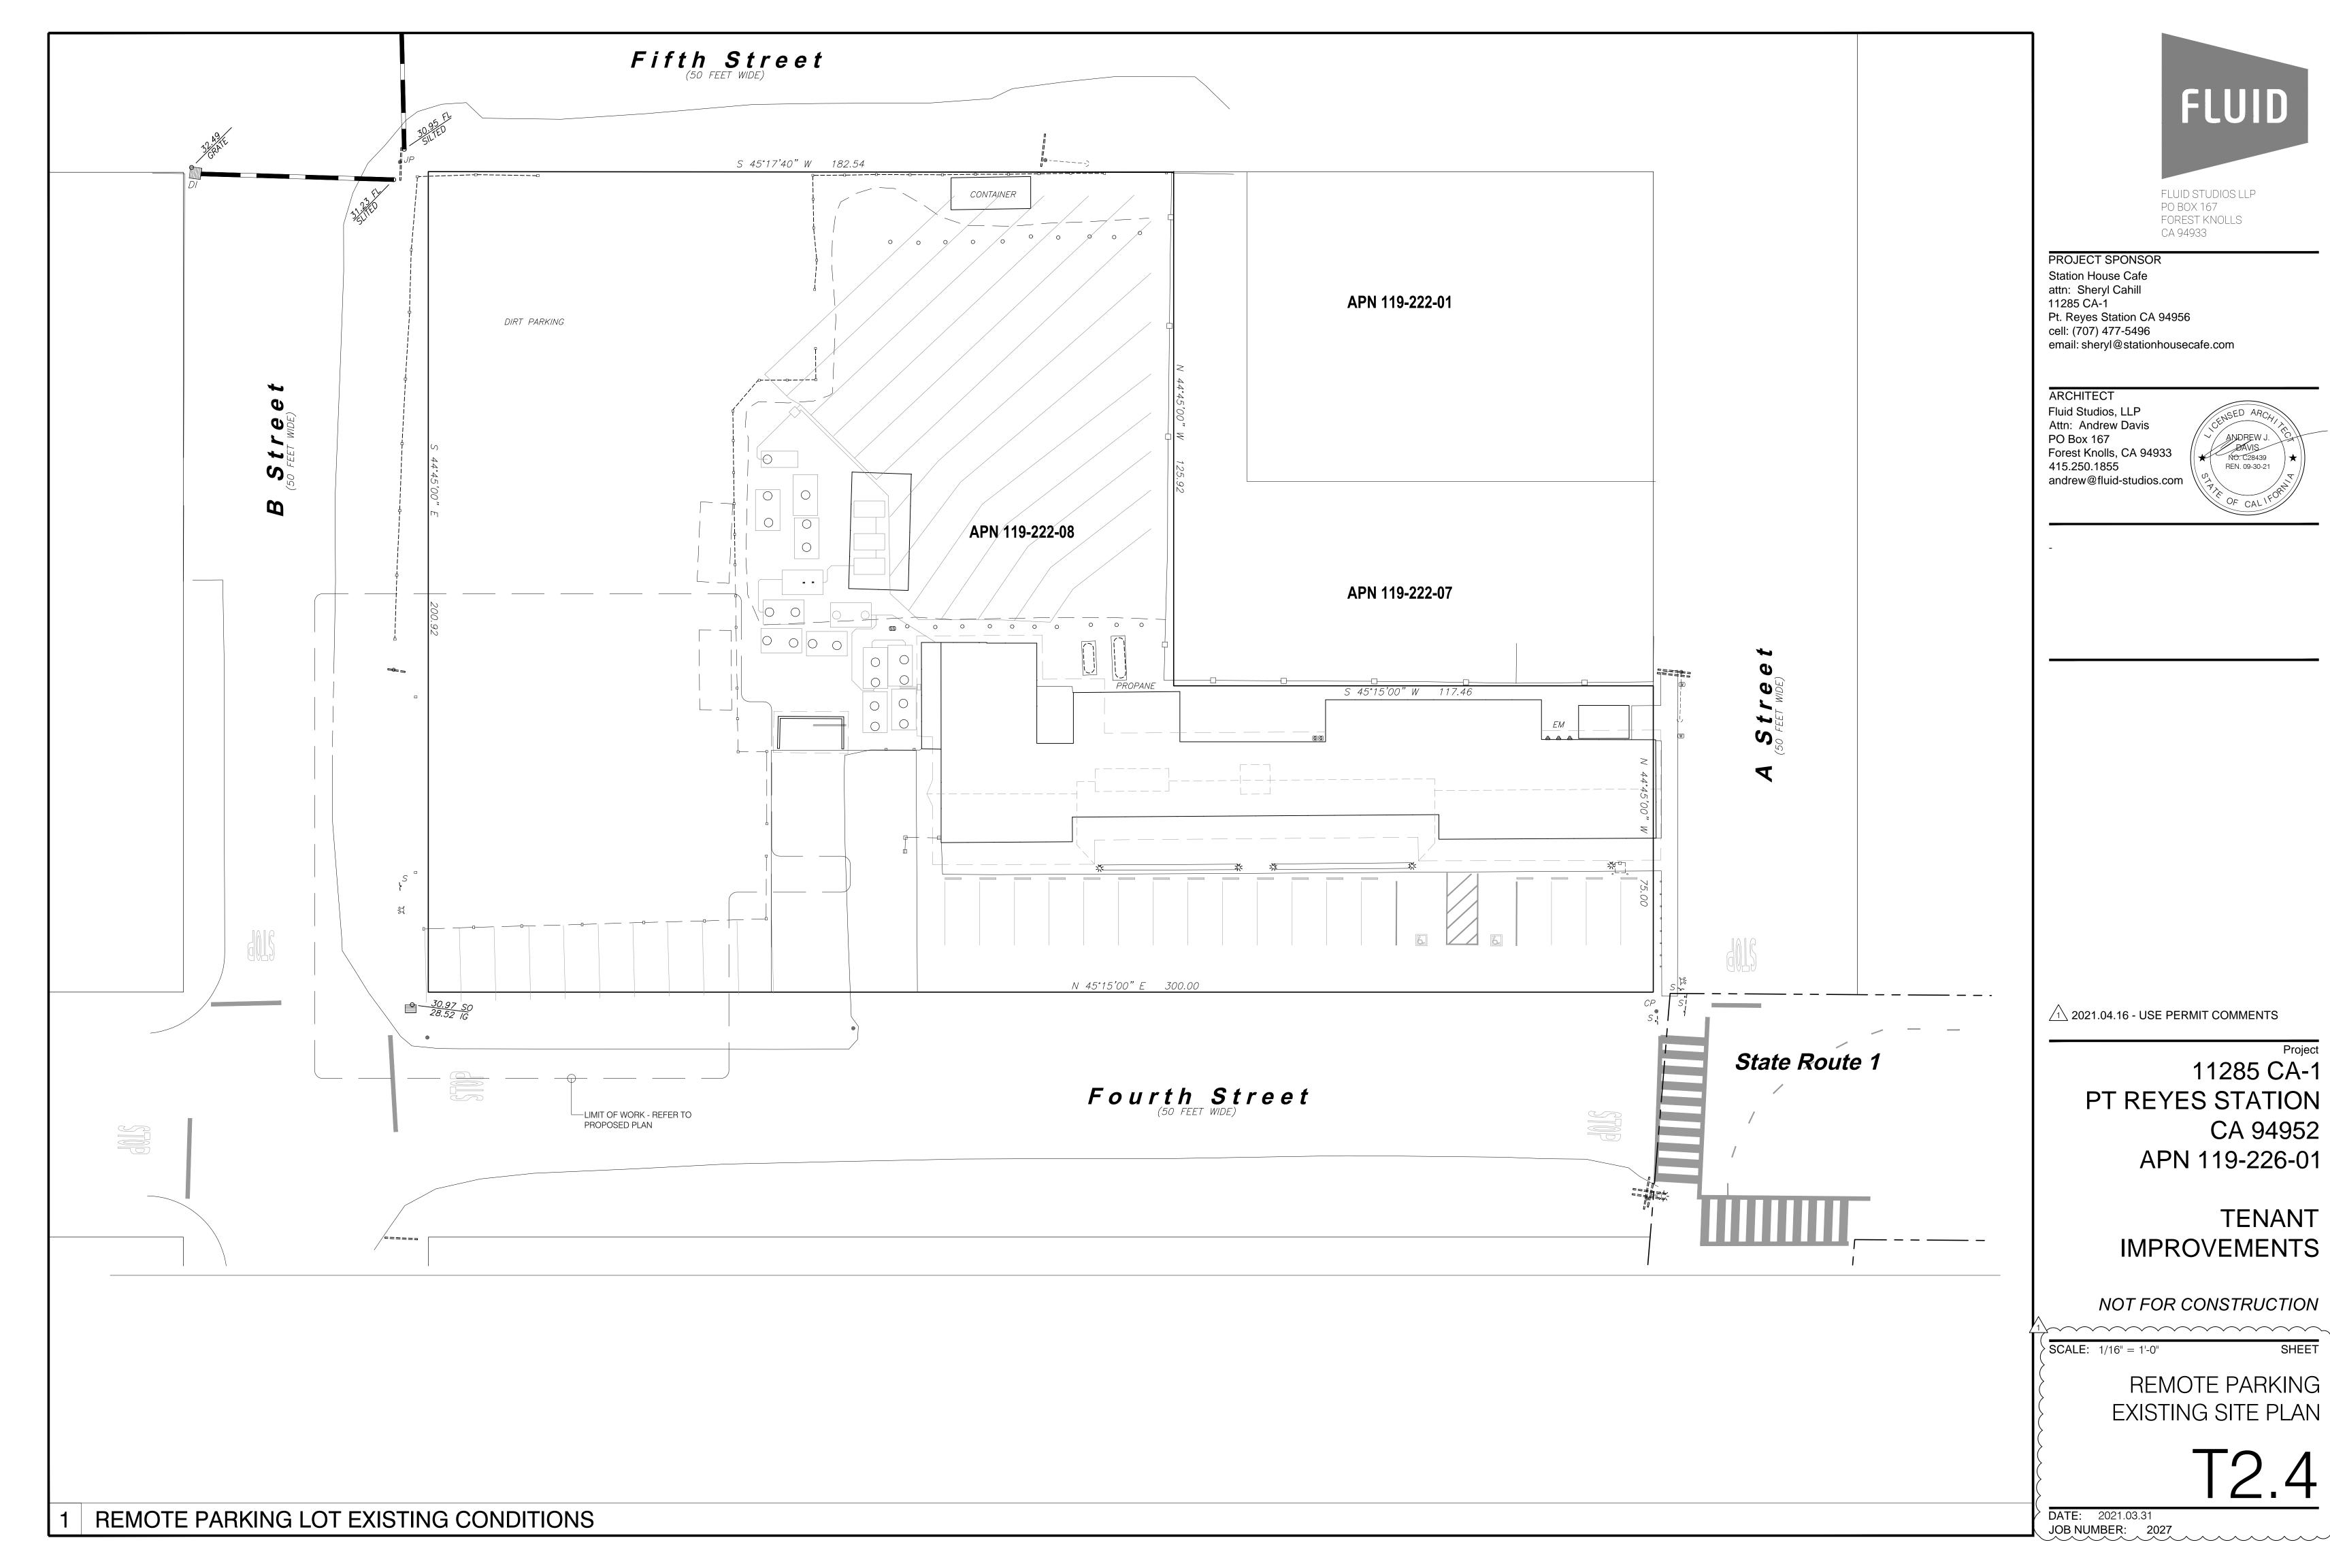


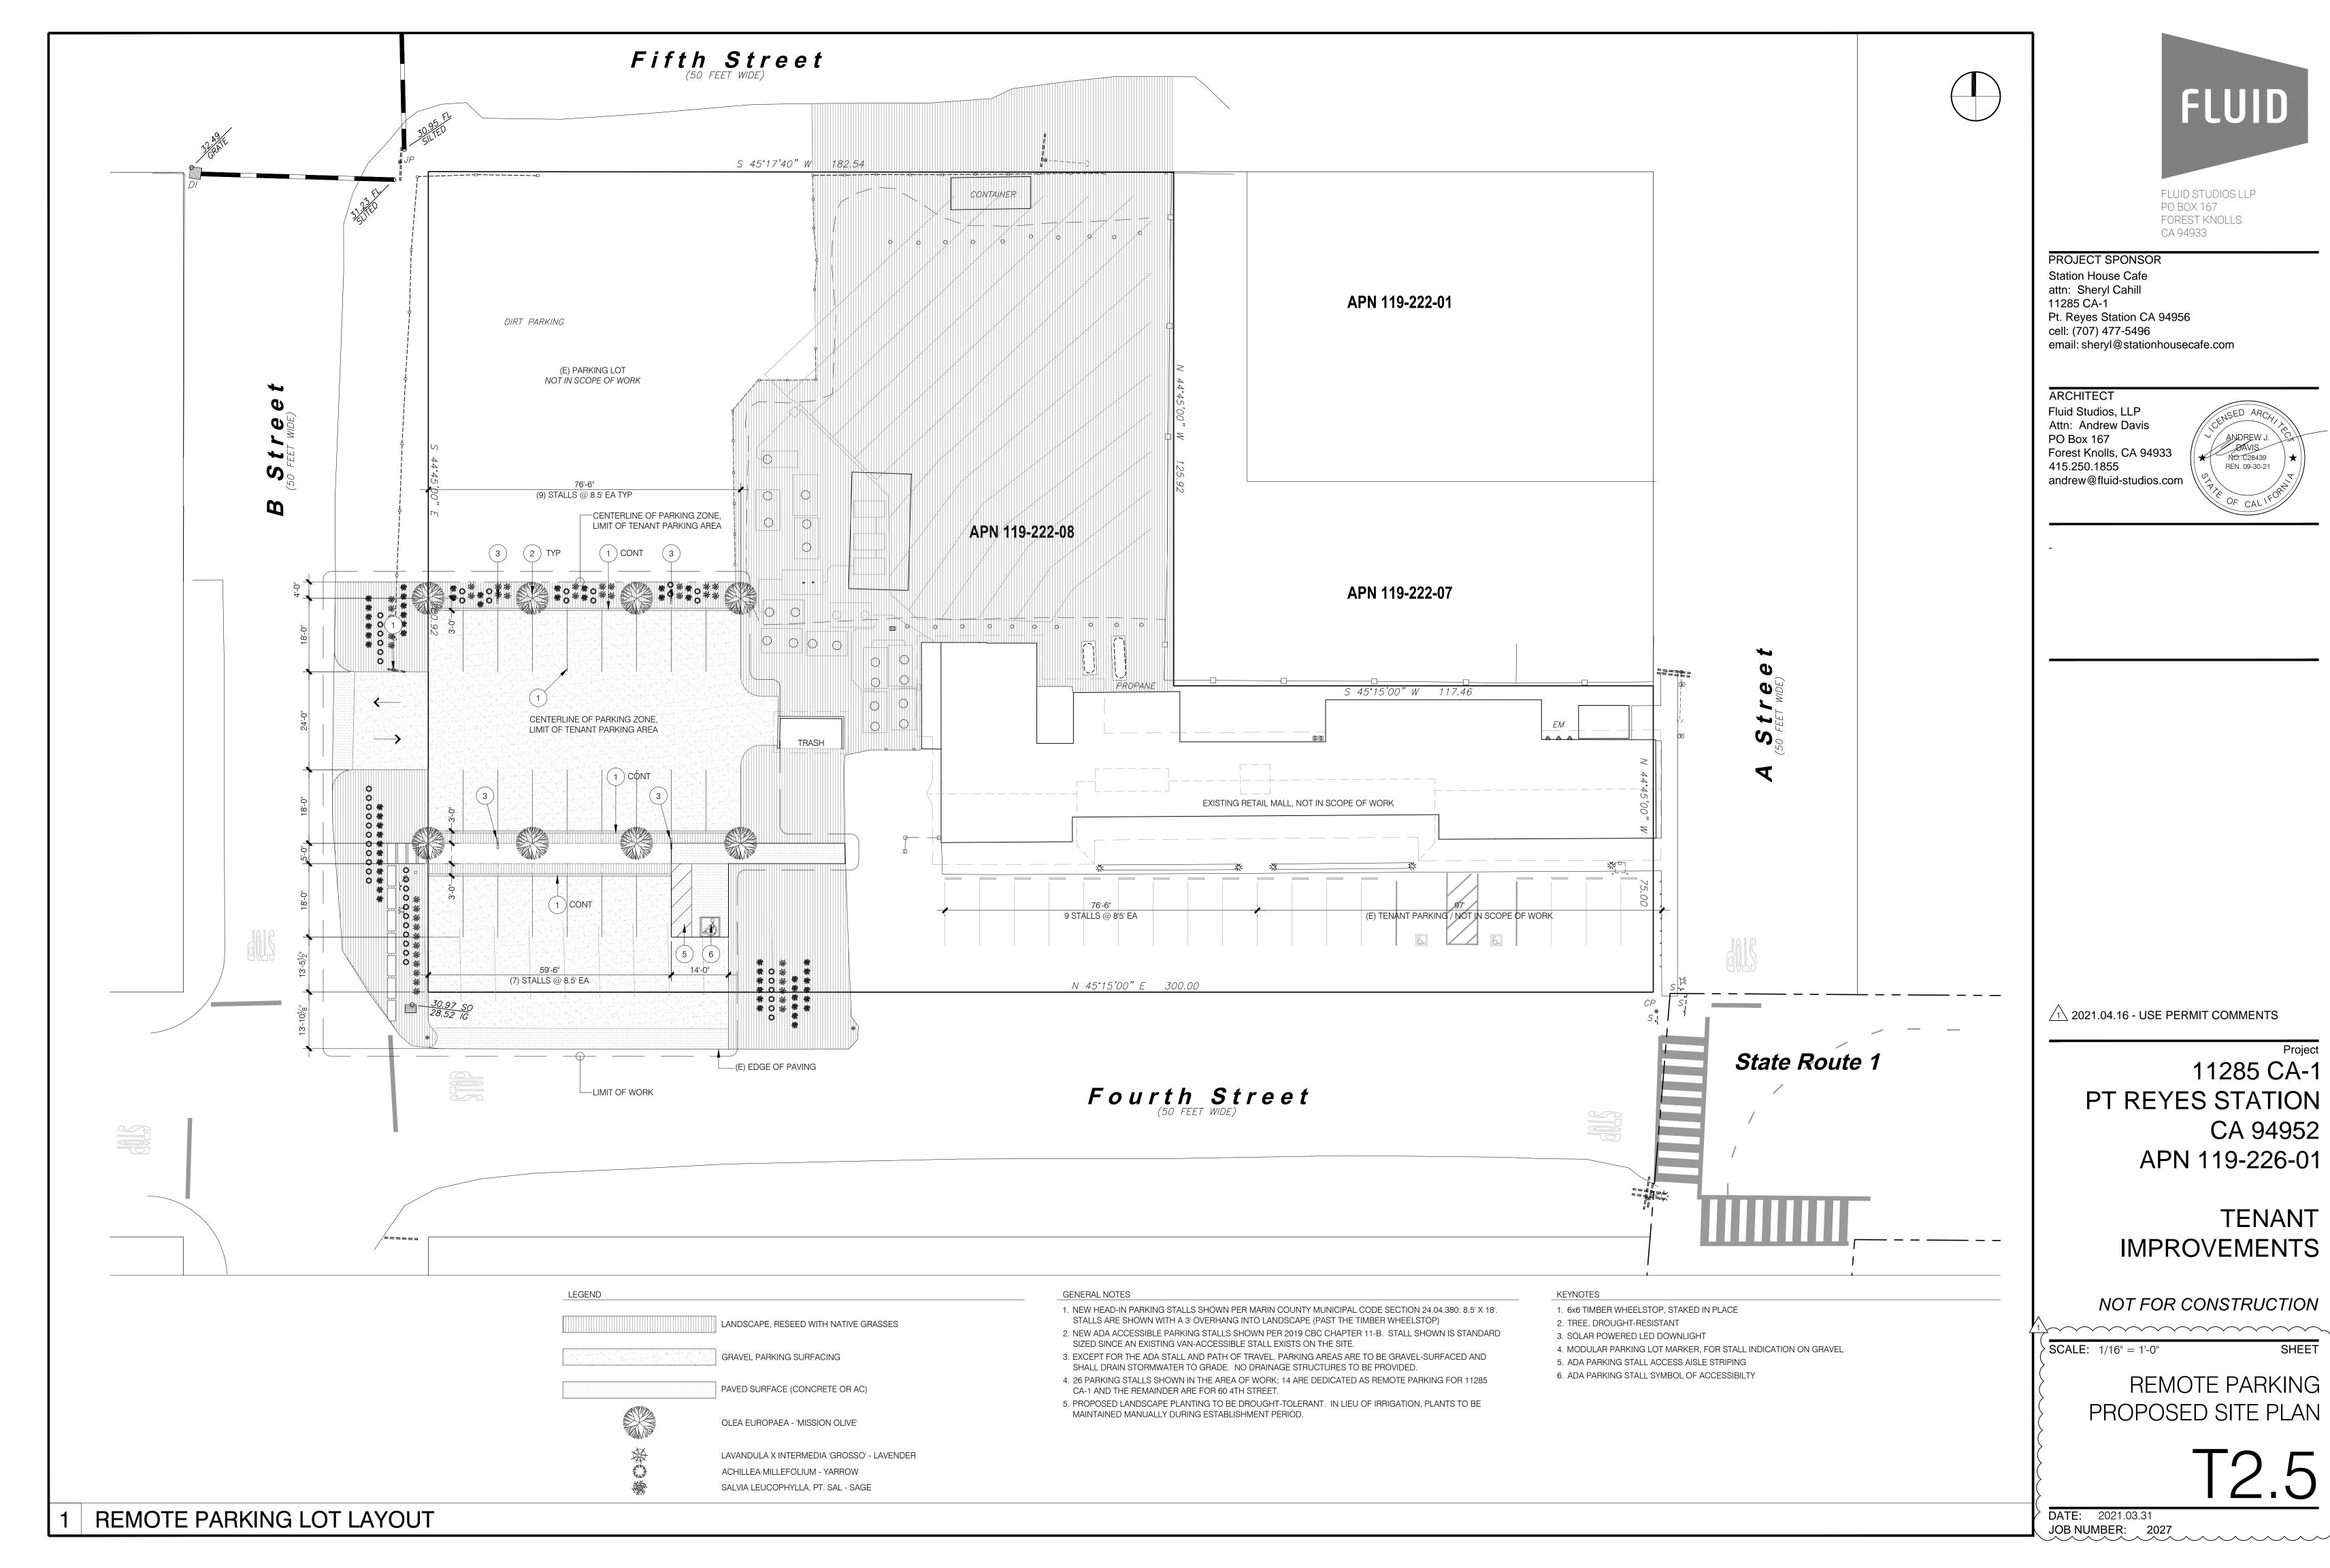

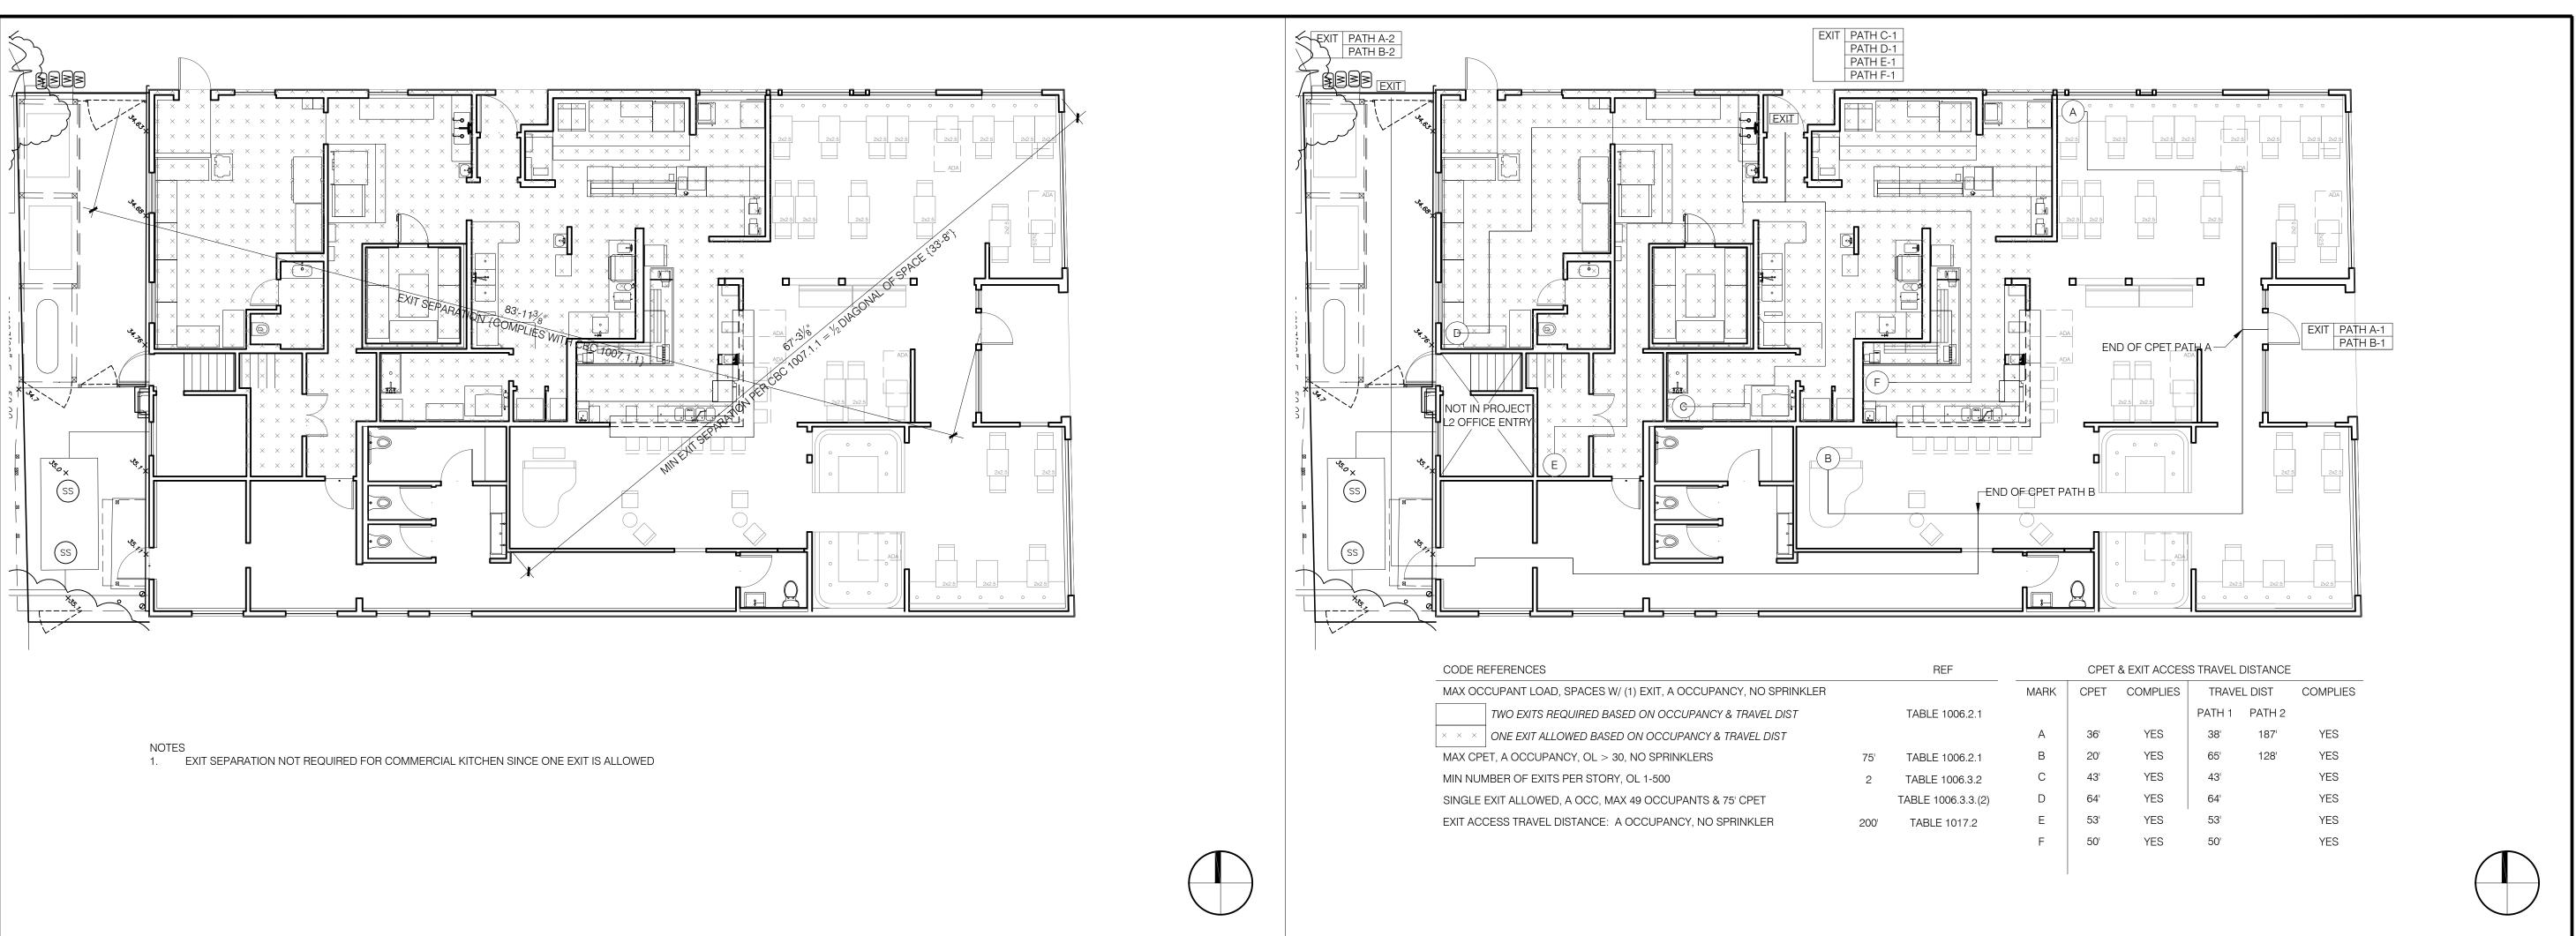




ARCHITECT
Fluid Studios, LLP
Attn: Andrew Davis
PO Box 167
Forest Knolls, CA 94933
415.250.1855
andrew@fluid-studios.com

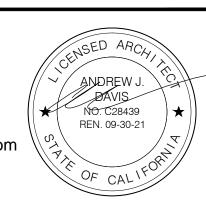

24 EXIT SEPARATION

02 CPET, EXIT ACCESS TRAVEL DISTANCE

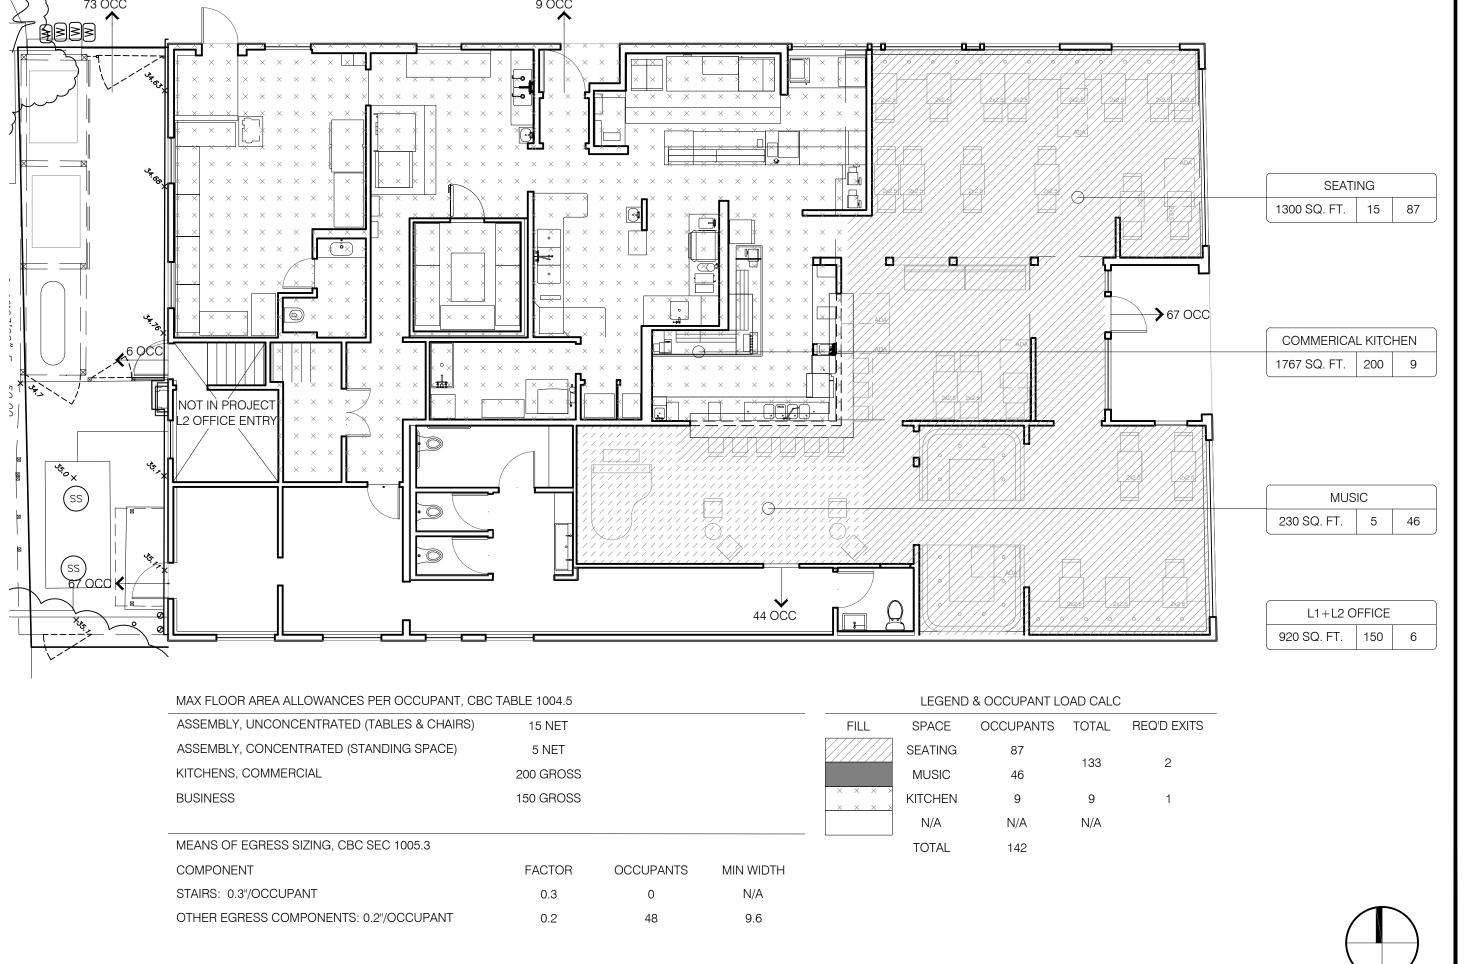

1 2021.04.16 - USE PERMIT COMMENTS

11285 CA-1
PT REYES STATION
CA 94952
APN 119-226-01

TENANT IMPROVEMENTS

NOT FOR CONSTRUCTION


SCALE: 1/8" = 1'-0"

DATE: 2021.04.16 JOB NUMBER: 2027


CODE ANALYSIS




01 OCCUPANT LOAD CALC

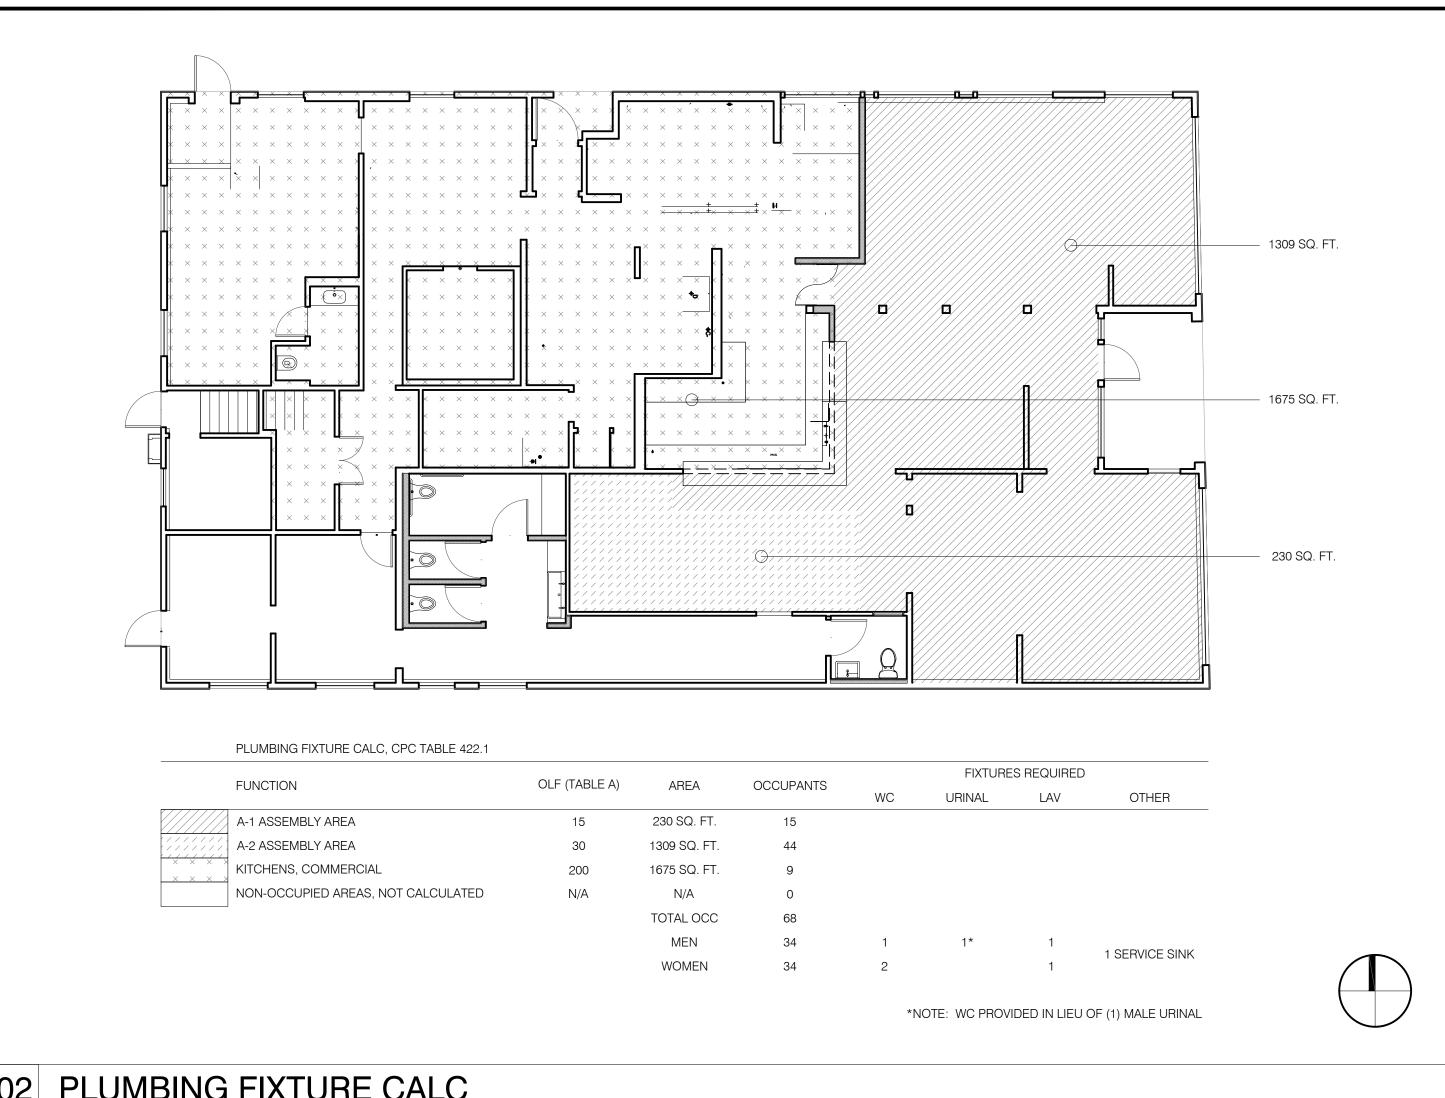

02 PLUMBING FIXTURE CALC

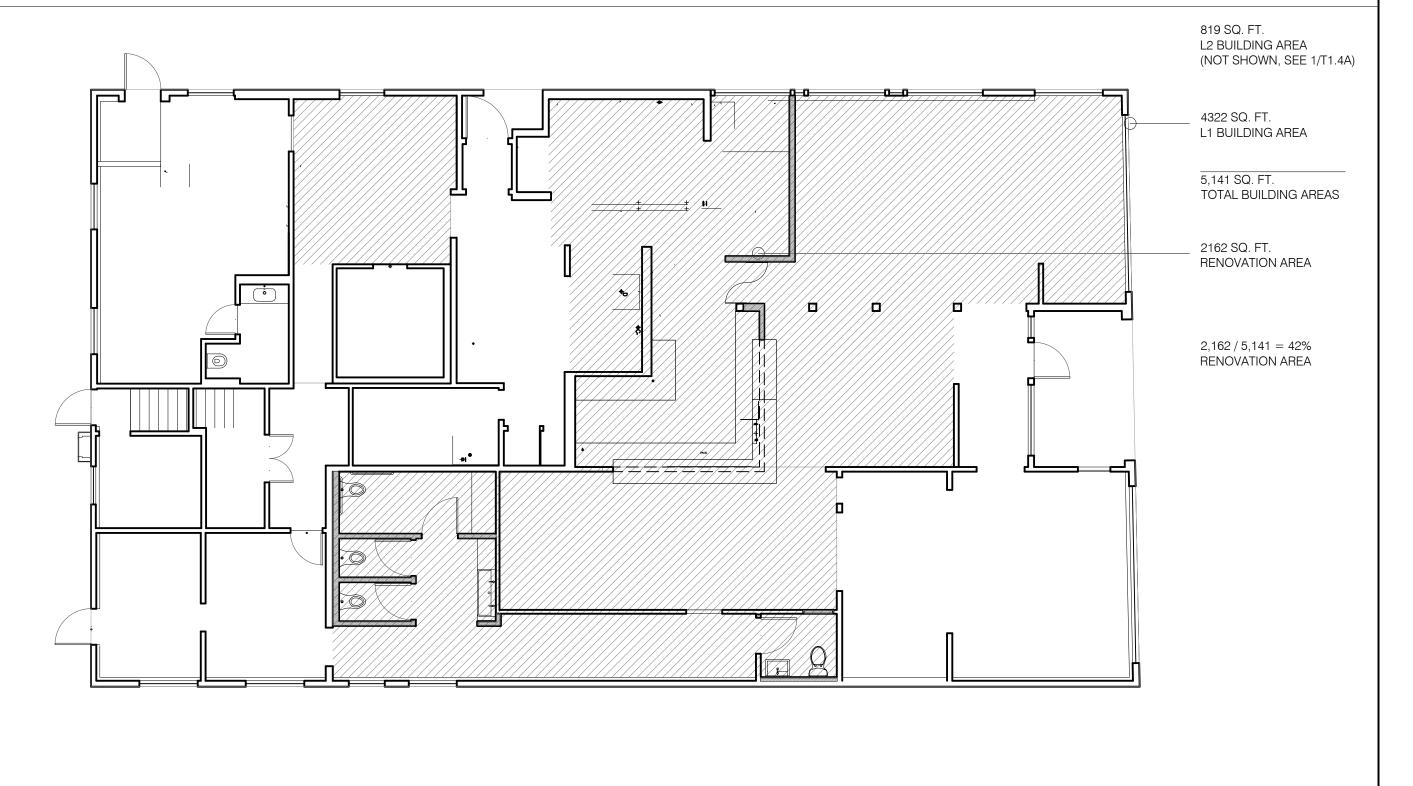

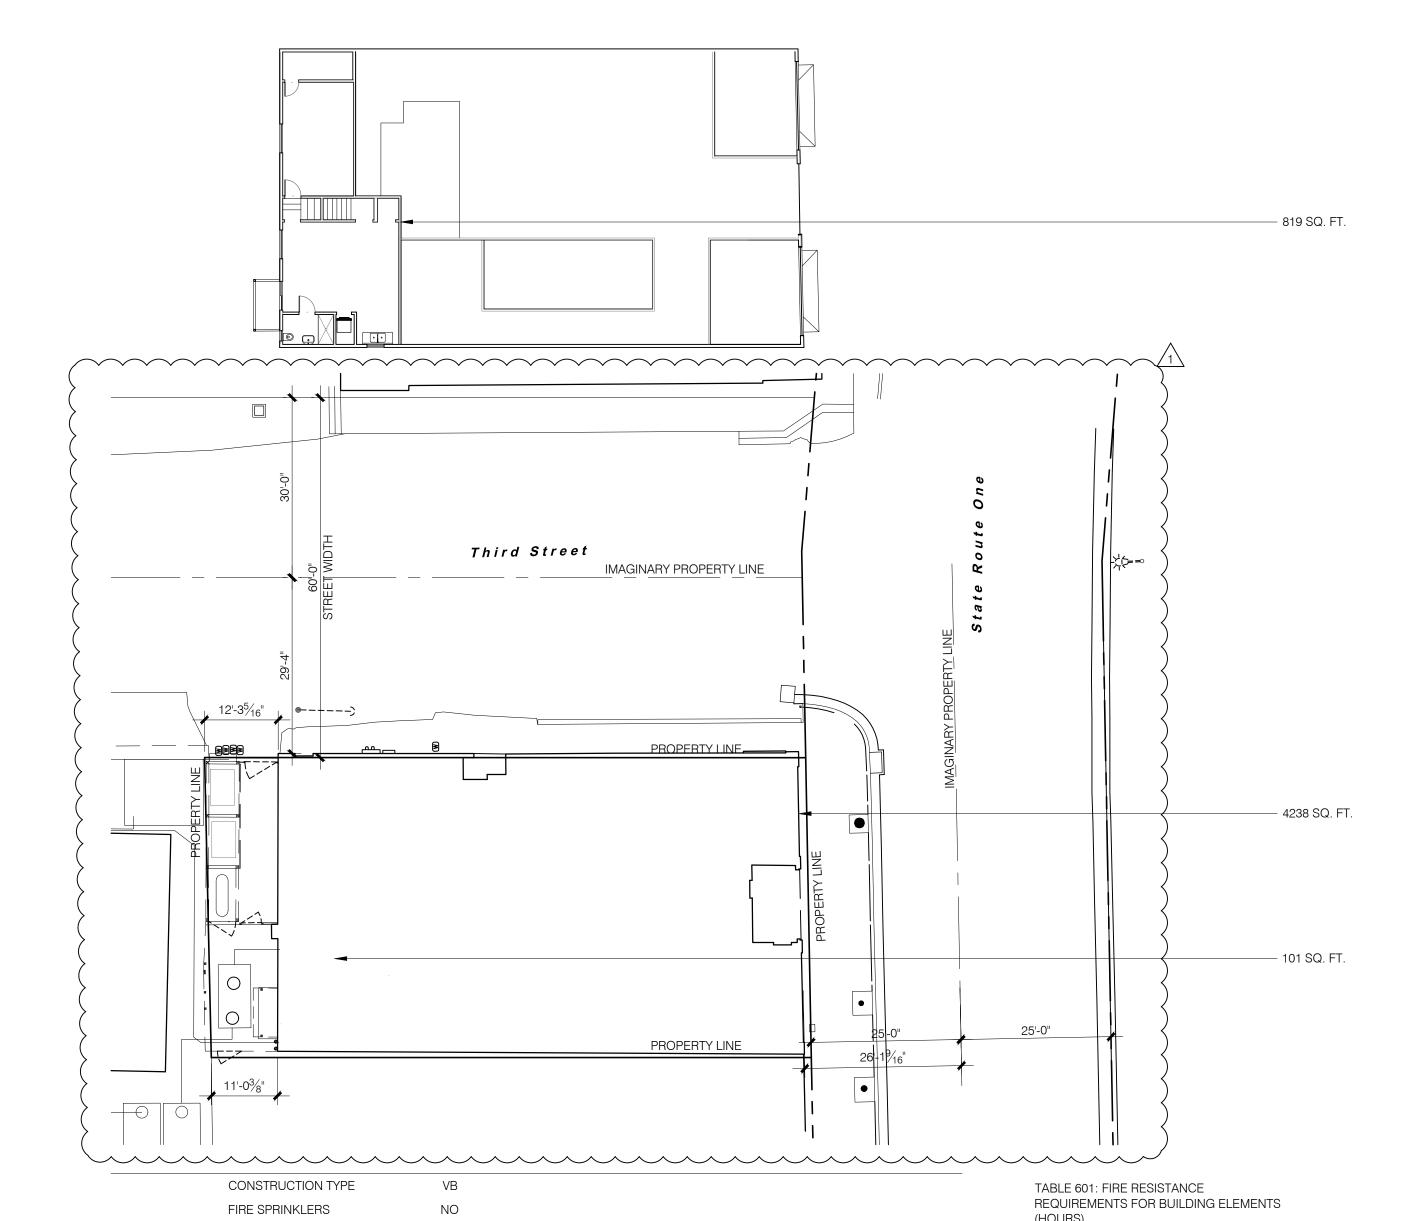

BUILDING						
INFORMATION	L1 FLOOR AREA	4238 SQ. FT.				
	L2 FLOOR AREA	819 SQ. FT.				
	TOTAL FLOOR AREA	5058 SQ. FT.				
		MAX ALLOW	EXISTING	COMPLIES	CODE REF	
	HEIGHT	40¹			TABLE 504.3	
ALLOW HEIGHT & STORIES	STORIES, A-2 NS	1	1	YES	TABLE 504.4	
	STORIES, B NS	2	2	YES	TABLE 504.4	
ALLOWABLE	A-2 NS	6,000 SQ. FT.			TABLE 506.2	
AREA FACTORS	B NS	9,000 SQ. FT.			TABLE 506.2	

A-2, B

OCCUPANCY GROUP

THEY ARE LOCATED.

508.1

508.2

508.3.2

VEL	OCCPANCY GROUP	AREA	At {CBC 506.2}	PROPOSED AREA {AREA / At}	
	A-2	4238 SQ. FT.	6000	0.70	< 1 PER CBC 508.4.2
	В	101 SQ. FT.	9000	0.01	< 1 PER CBC 508.4.2
	В	819 SQ. FT.	9000	0.1.1	< 1 PER CBC 508.4.2
	TOTAL	5159 SQ. FT.			

ALLOWABLE AREA OF MIXED-OCCUPANCY, MULTISTORY BUILDING AREA - CBC 506.2.4 {NO FRONTAGE INCREASE CALCULATED}

EACH PORTION OF A BUILDING SHALL BE INDIVIDUALLY CLASSIFIED IN ACCORDANCE WITH SECTION
302.1. WHERE A BUILDING CONTAINS MORE THAN ONE OCCUPANCY GROUP, THE BUILDING OR PORTION
THEREOF SHALL COMPLY WITH THE APPLICABLE PROVISIONS OF SECTION 508.2, 508.3, OR 508.4, OR A
COMBINATION OF THESE SECTIONS.

508.3	NONSEPARATED OCCUPANCIES SHALL BE INDIVIDUALLY CLASSIFIED & CODE REQUIREMENTS APPLY TO EACH PORTION OF THE BUILDING BASED ON THE OCCUPANCY CLASSIFICATION OF THAT SPACE.

THE ALLOWABLE BUILDING AREA, HEIGHT AND NUMBER OF STORIES OF THE BUILDING OR PORTION THEREOF SHALL BE BASED ON THE MOST RESTRICTIVE ALLOWANCES FRO THE OCCUPANCY GROUP
UNDER CONSIDERATION.

NO SEPARATION IS REQURIED BETWEEN NONSEPARATED OCCUPANCIES

N/A {B ACCESSORY, ANCILLARY OCCUPANCIES, AREA < 10% OF THE FLOOR AREA OF THE STORY IN WHICH OCCUPANCY IS +/- 25% OF BUILDING **PORTIONS** COMPLY W/ NO OCCUPANCY SEPARATION

BUILDING ELEMENT

BEARING WALLS

EXTERIOR

INTERIOR

PARTITIONS, EXTERIOR

PARTITIONS, INTERIOR

ASSOC. SECONDARY

ASSOC. SECONDARY

SEPARATION < 5'

903.2.1.2 GROUP A2

SEPARATION > 5' & < 10' SEPARATION > 10' & < 30'

1. THE FIRE AREA EXCEEDS 5,000 SQ. FT.

2. THE FIRE AREA HAS AN

3. THE FIRE AREA IS LOCATED ON A LFOOR OTHER THAN A

SERVING SUCH OCCUPANCIES

4. THE STRUCTURE EXCEEDS

THAN ONE FIRE AREA

MORE BUILDINGS BY LESS THAN 4-HOUR W/OUT

5,000 SQ. FT., CONTAINS MORE

CONTAINING GROUP A-2, AND IS SEPARATED INTO TWO OR

LEVEL OF EXIT DISCHARGE

MEMBERS

MEMBERS

FLOOR CONSTRUCTION &

ROOF CONSTRUCTION &

TABLE 602: EXTERIOR WALL FIRE

RESISTANCE BASED ON FIRE SEPARATION

AUTOMATIC FIRE SPRINKLER WHERE ANY OF THE FOLLOWING CONDITIONS EXISTS:

OCCUPANT LOAD OF 100 OR N/A

PRIMARY STRUCTURAL FRAME

TABLE 602

NONBEARING WALLS AND TABLE 602 1 2021.04.16 - USE PERMIT COMMENTS

> 11285 CA-1 PT REYES STATION CA 94952 APN 119-226-01

FLUID STUDIOS LLP

PO BOX 167 FOREST KNOLLS

CA 94933

PROJECT SPONSOR Station House Cafe attn: Sheryl Cahill

cell: (707) 477-5496

Pt. Reyes Station CA 94956

email: sheryl@stationhousecafe.com

11285 CA-1

ARCHITECT

PO Box 167

415.250.1855

Fluid Studios, LLP

Attn: Andrew Davis

Forest Knolls, CA 94933

andrew@fluid-studios.com


TENANT IMPROVEMENTS

NOT FOR CONSTRUCTION

SCALE: 1/8" = 1'-0"


DATE: 2021.04.16 JOB NUMBER: 2027

CODE ANALYSIS

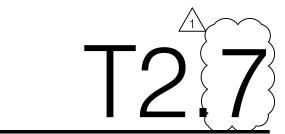

03 AREA OF WORK CALC

01 GENERAL BUILDING LIMITATIONS ANALYSIS

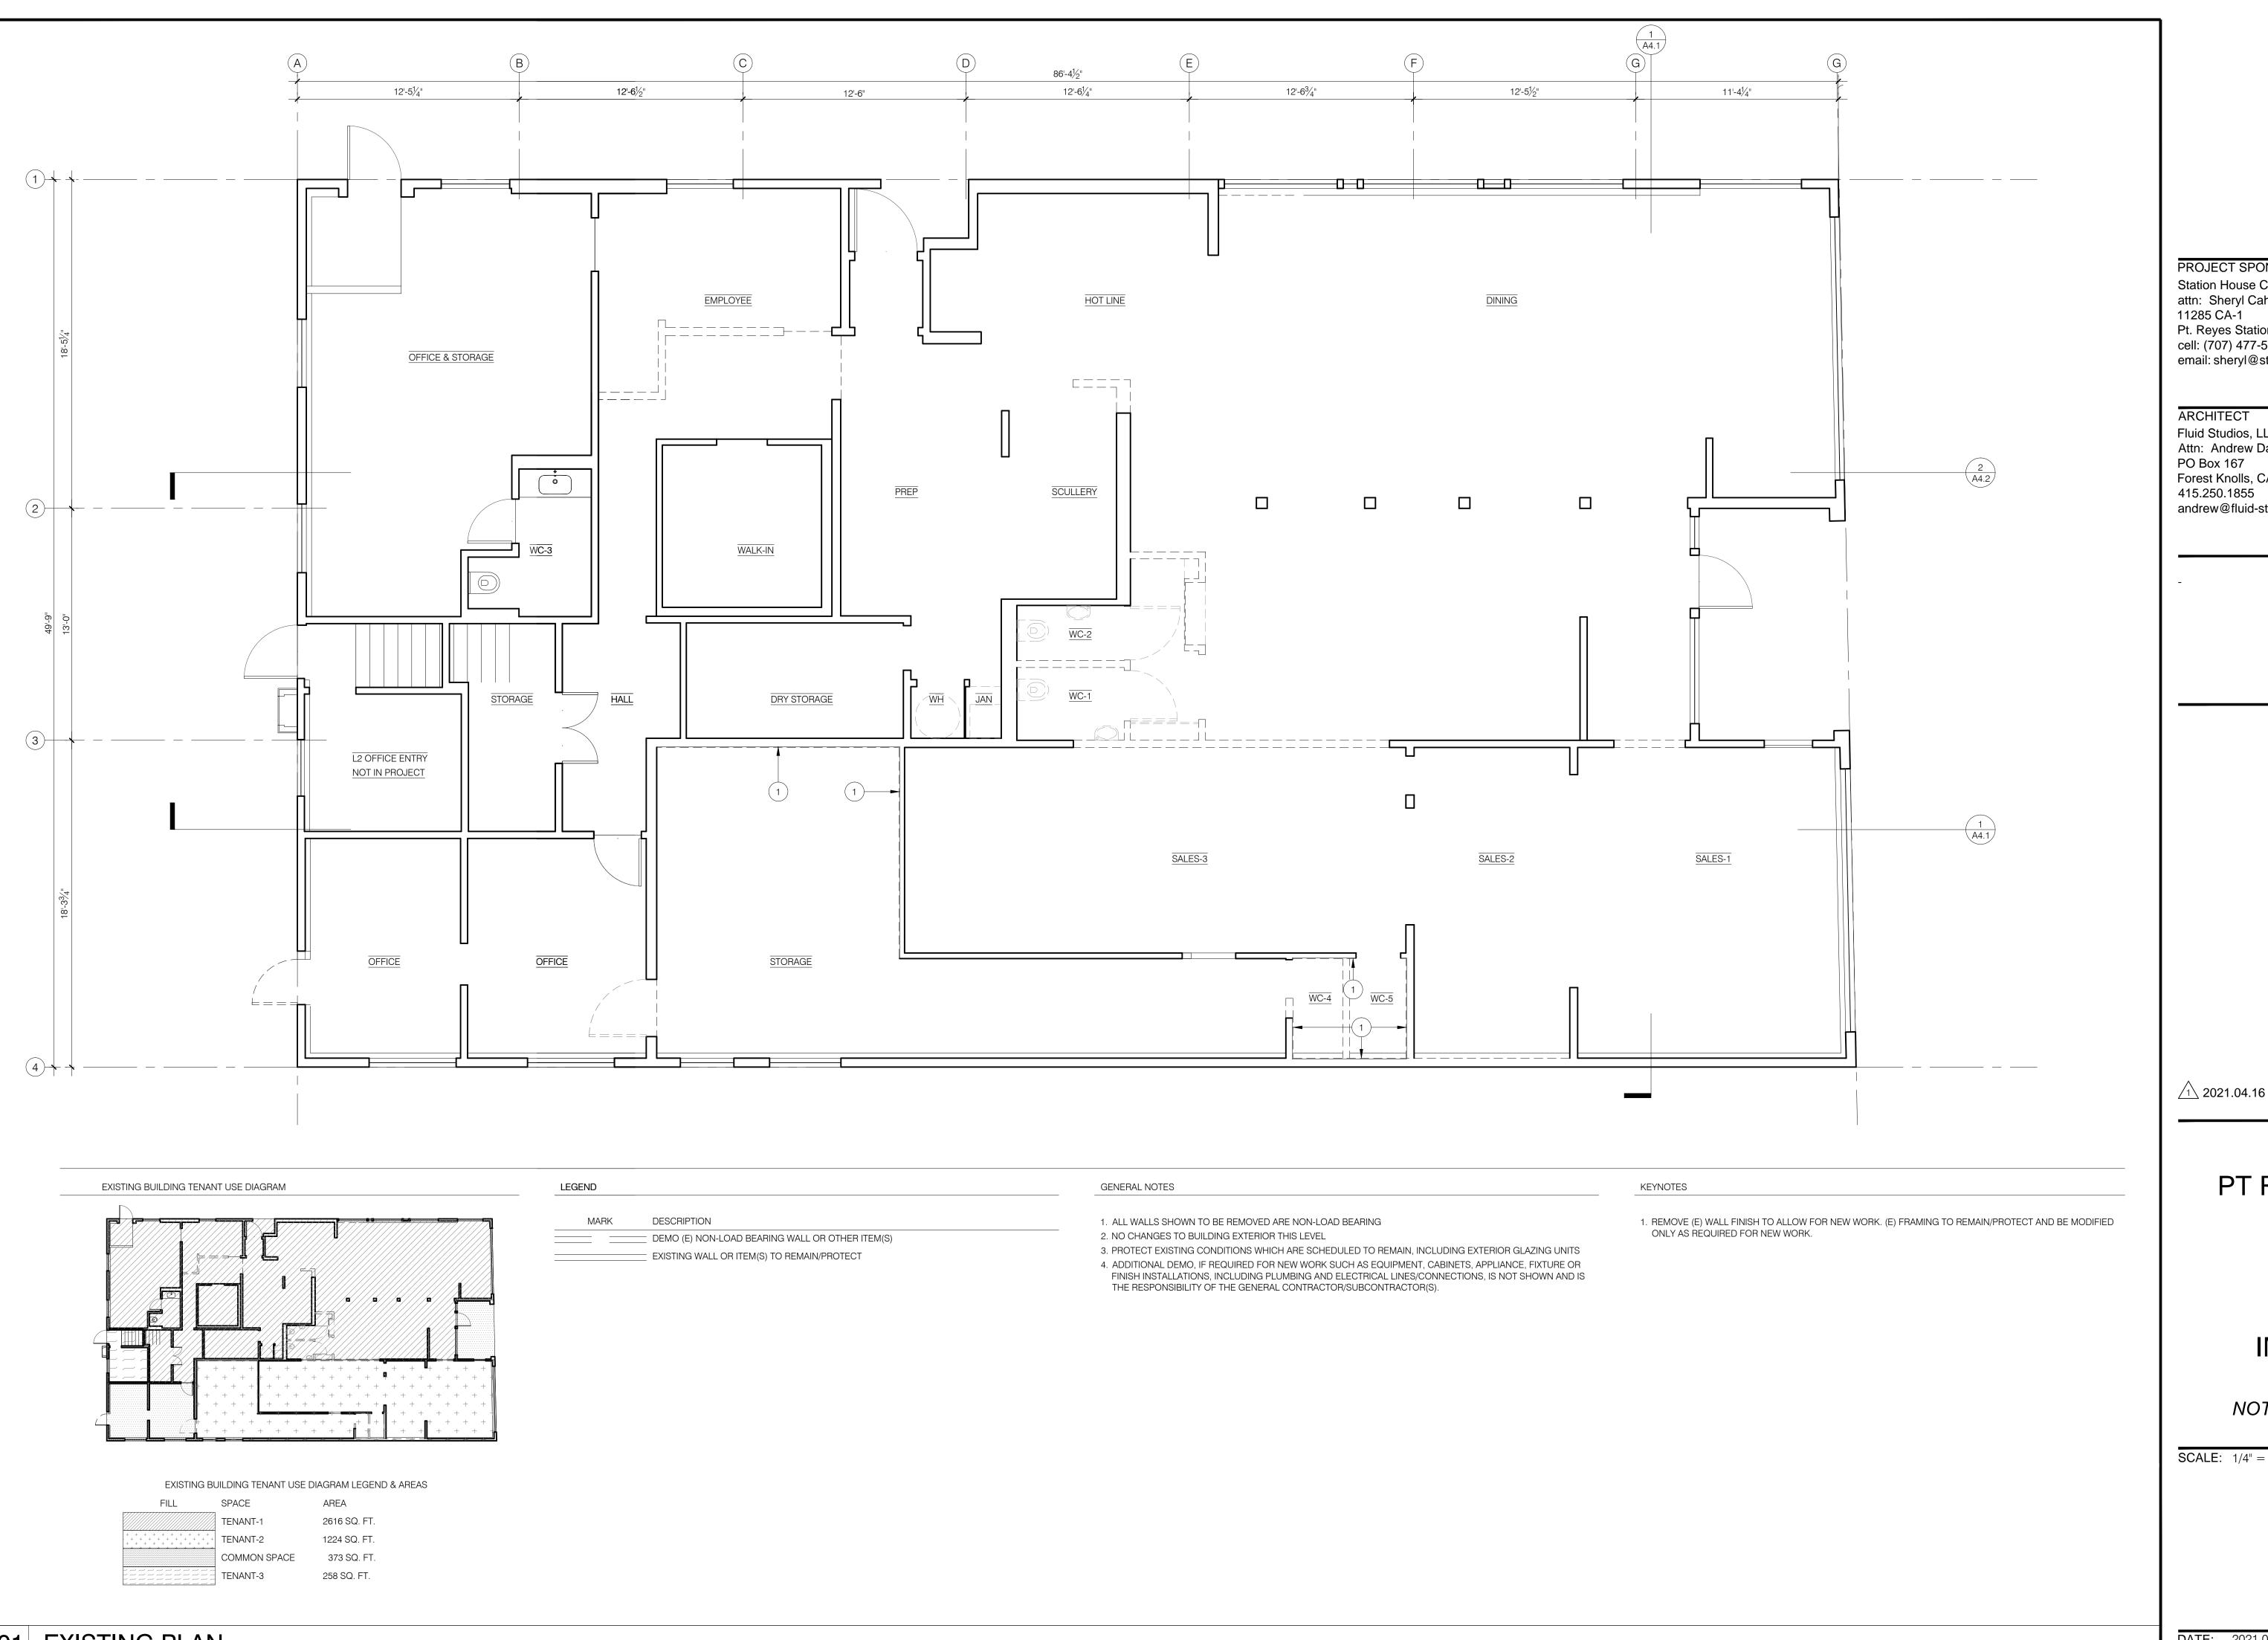

FLUID STUDIOS LLP PO BOX 167 FOREST KNOLLS CA 94933

PROJECT SPONSOR Station House Cafe attn: Sheryl Cahill Pt. Reyes Station CA 94956 cell: (707) 477-5496 email: sheryl@stationhousecafe.com

Fluid Studios, LLP Attn: Andrew Davis Forest Knolls, CA 94933 andrew@fluid-studios.com

2021.04.16 - USE PERMIT COMMENTS


11285 CA-1 PT REYES STATION CA 94952 APN 119-226-01


> **TENANT IMPROVEMENTS**

NOT FOR CONSTRUCTION

SCALE: 1/4" = 1'-0"

L1 DEMO PLAN

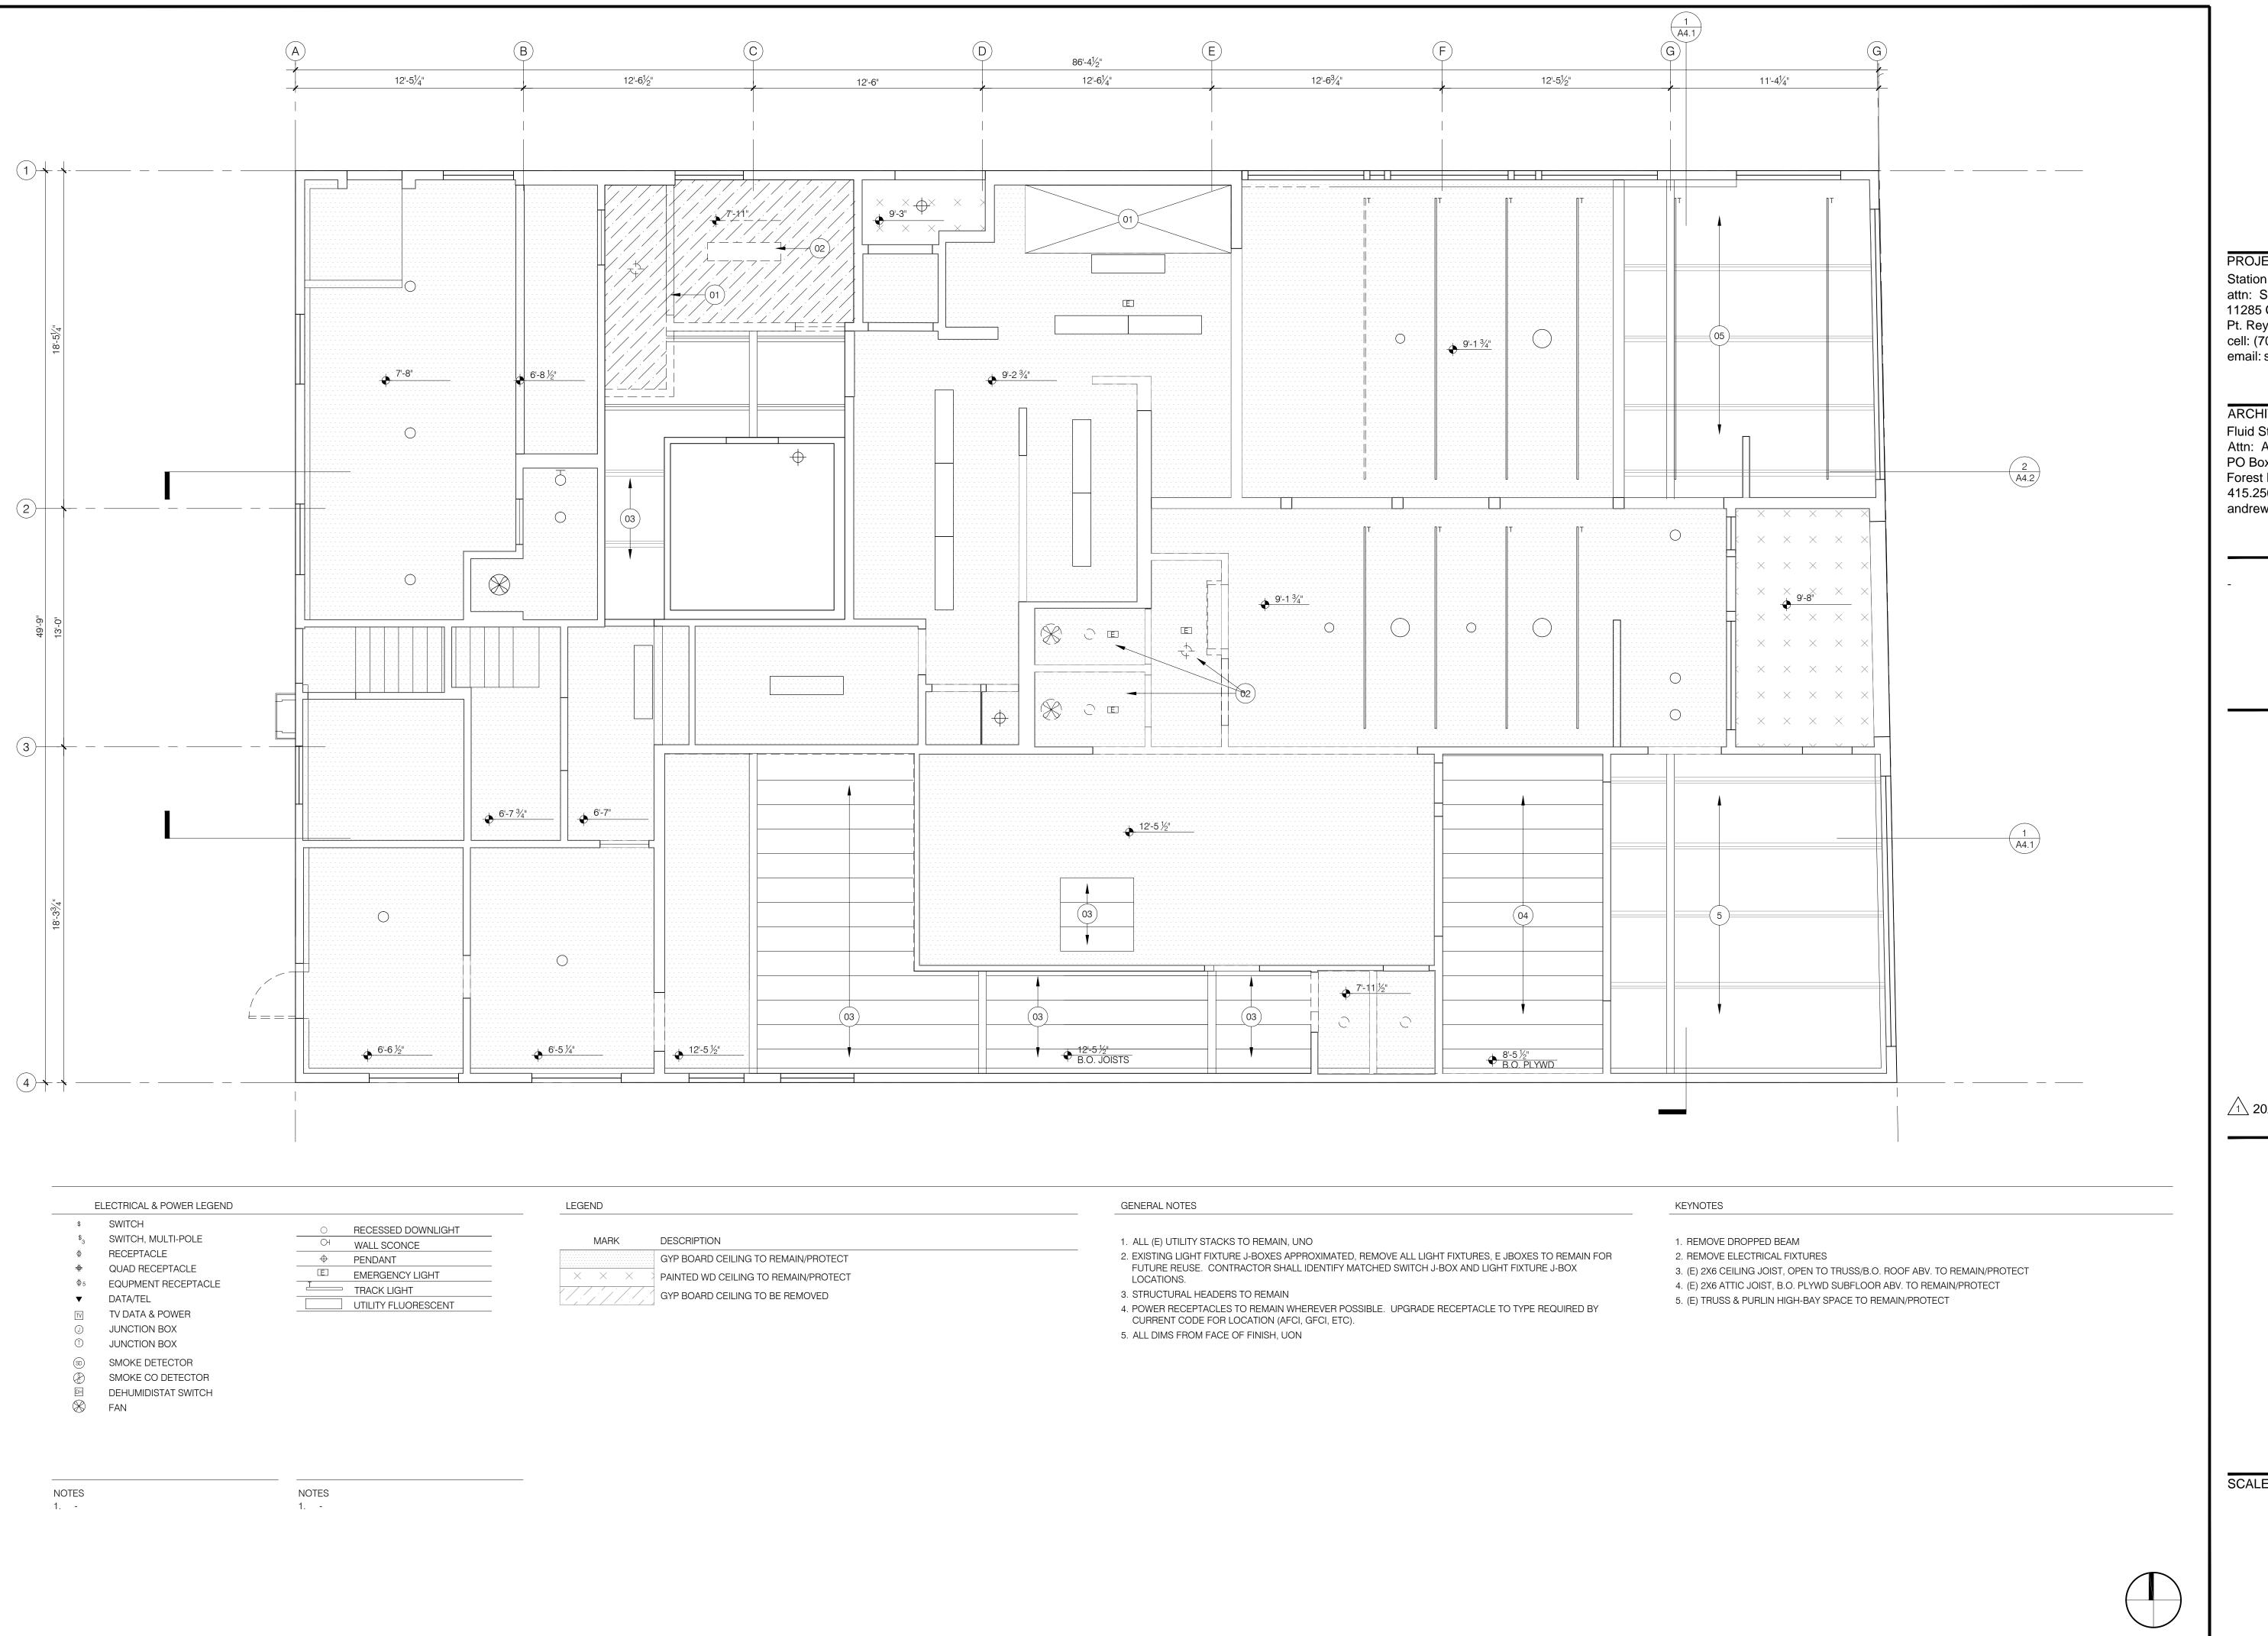

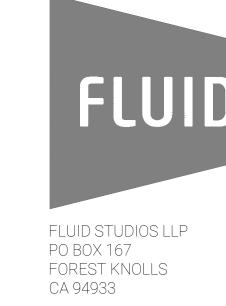

ARCHITECT
Fluid Studios, LLP
Attn: Andrew Davis
PO Box 167
Forest Knolls, CA 94933
415.250.1855
andrew@fluid-studios.com

1 2021.04.16 - USE PERMIT COMMENTS

11285 CA-1
PT REYES STATION
CA 94952
APN 119-226-01

TENANT IMPROVEMENTS


NOT FOR CONSTRUCTION


SCALE: 1/4" = 1'-0"

SHEET

L1 DEMO RCP

A2.2

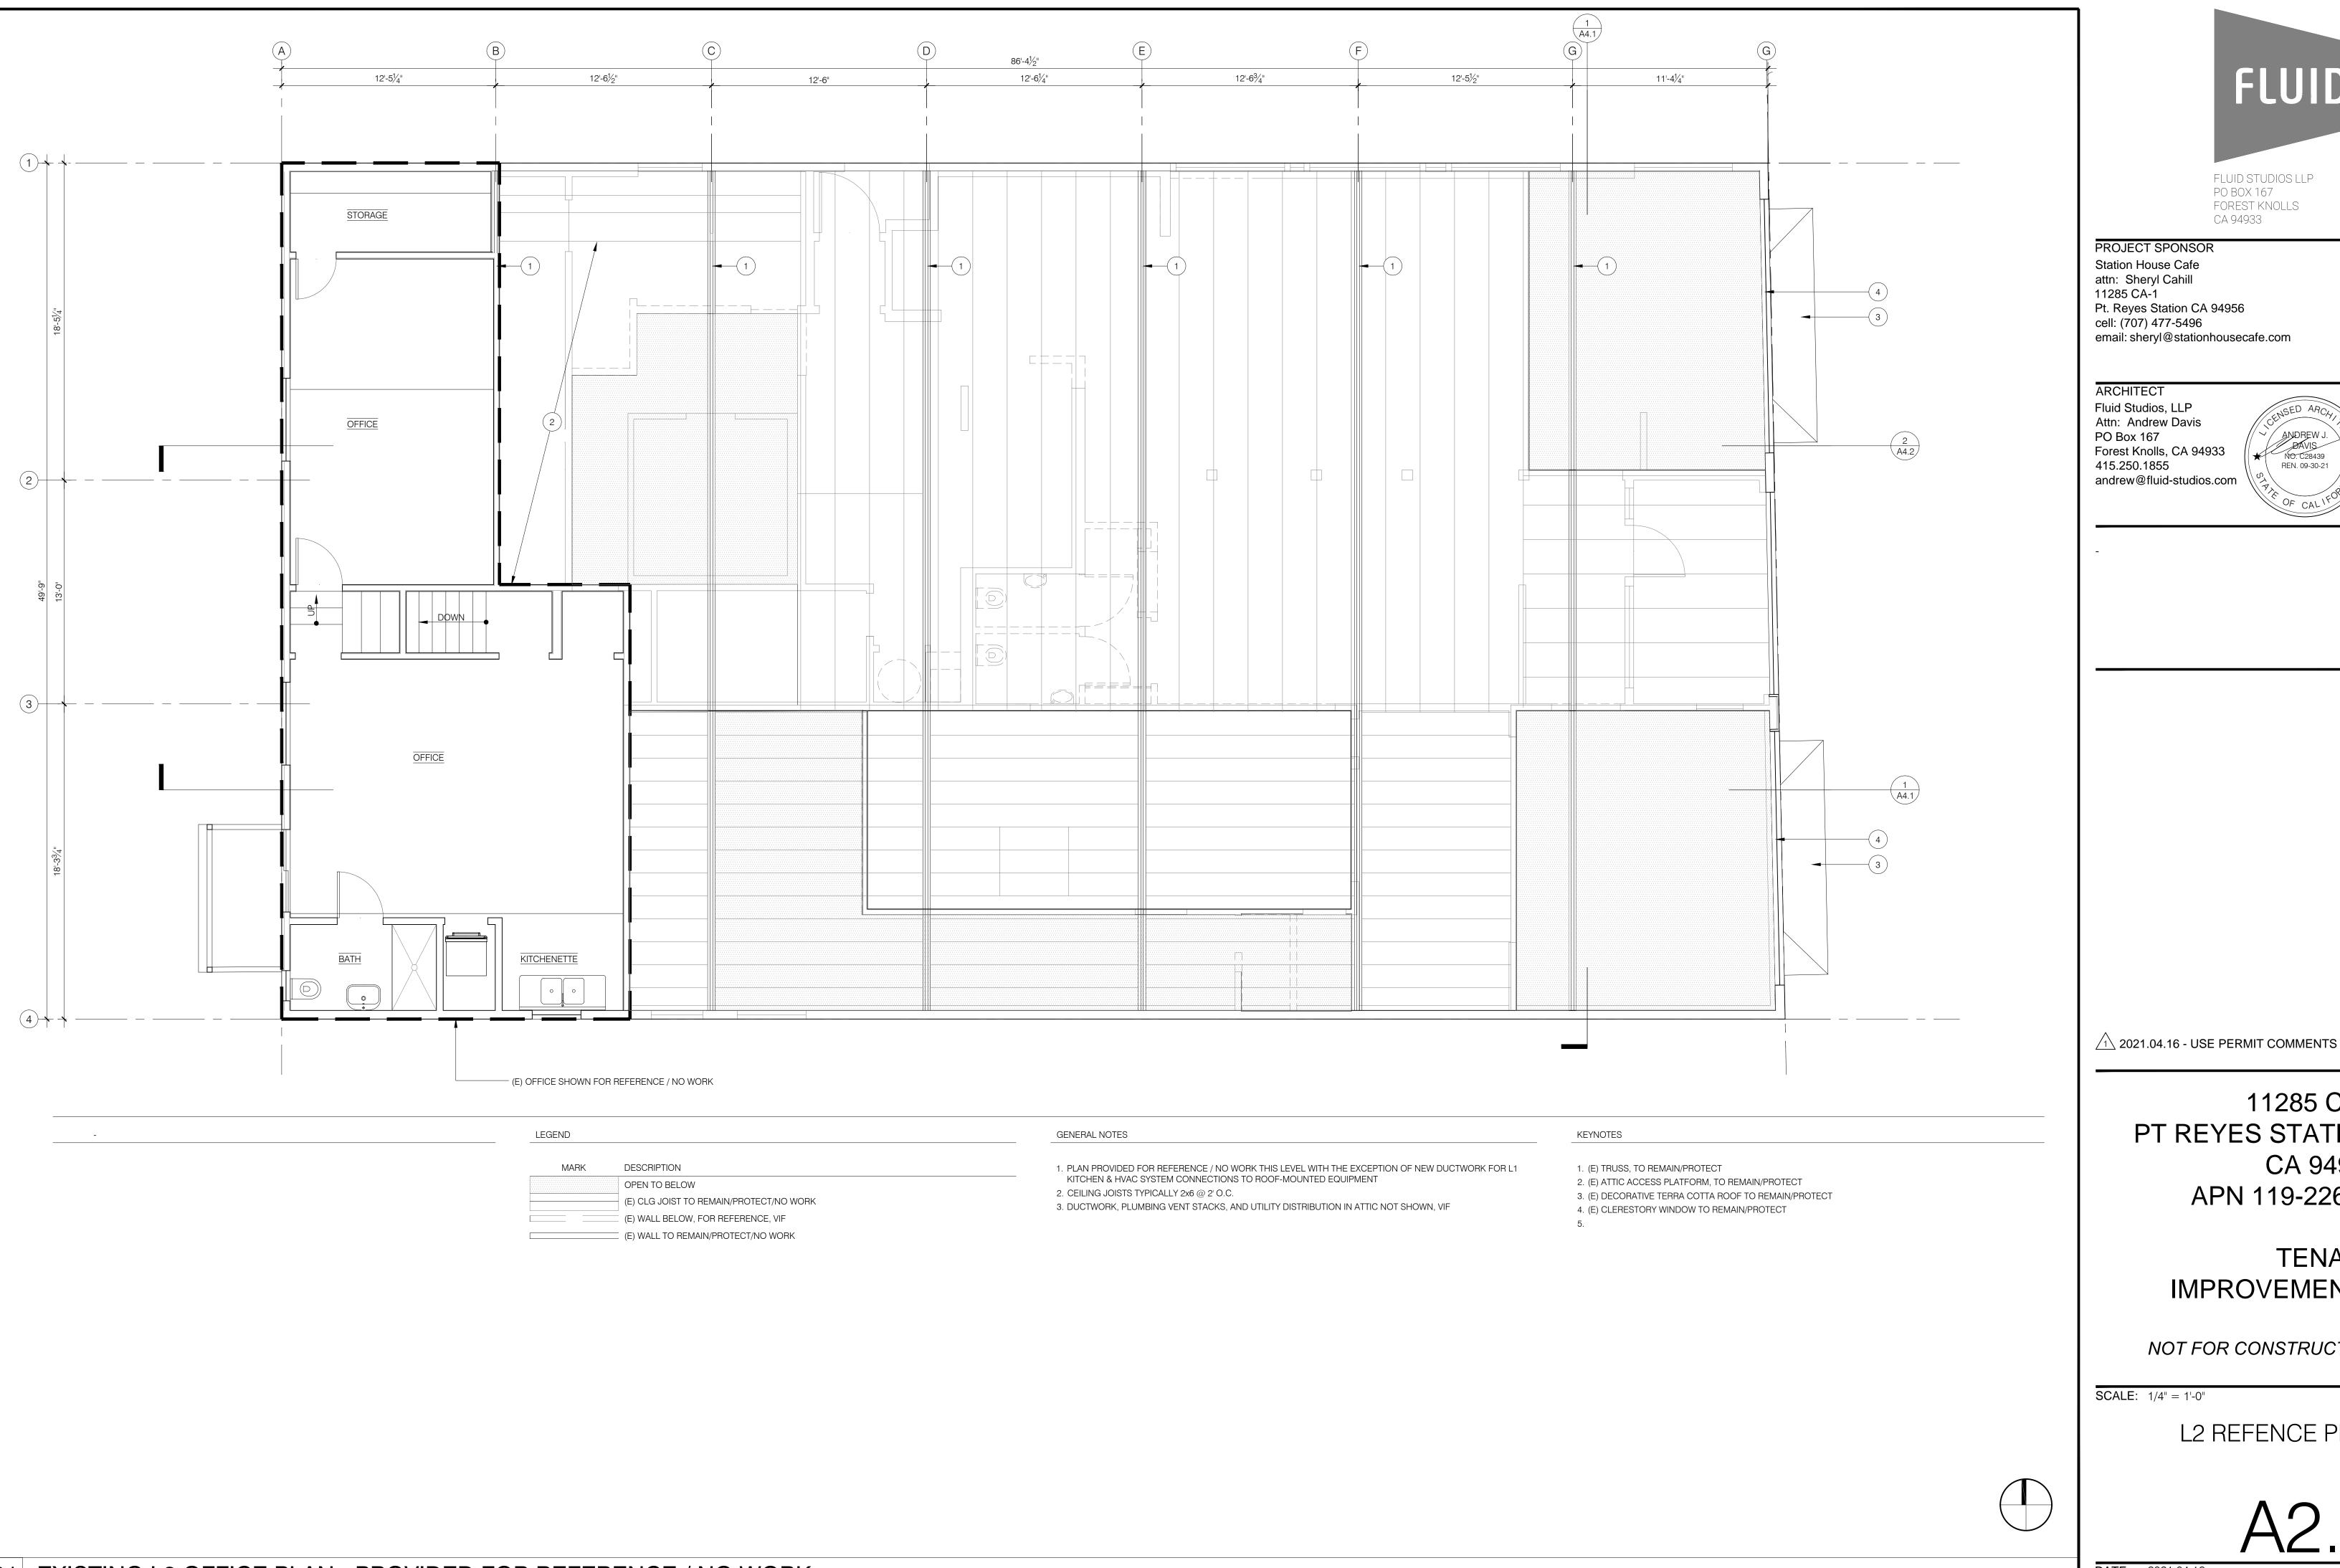

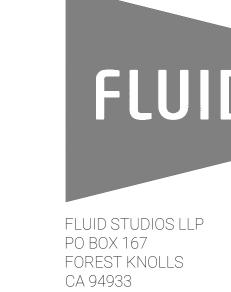

ARCHITECT Fluid Studios, LLP Attn: Andrew Davis PO Box 167 Forest Knolls, CA 94933 415.250.1855 andrew@fluid-studios.com


11285 CA-1 PT REYES STATION CA 94952 APN 119-226-01

> **TENANT IMPROVEMENTS**

NOT FOR CONSTRUCTION

SCALE: 1/4" = 1'-0"

L2 REFENCE PLAN

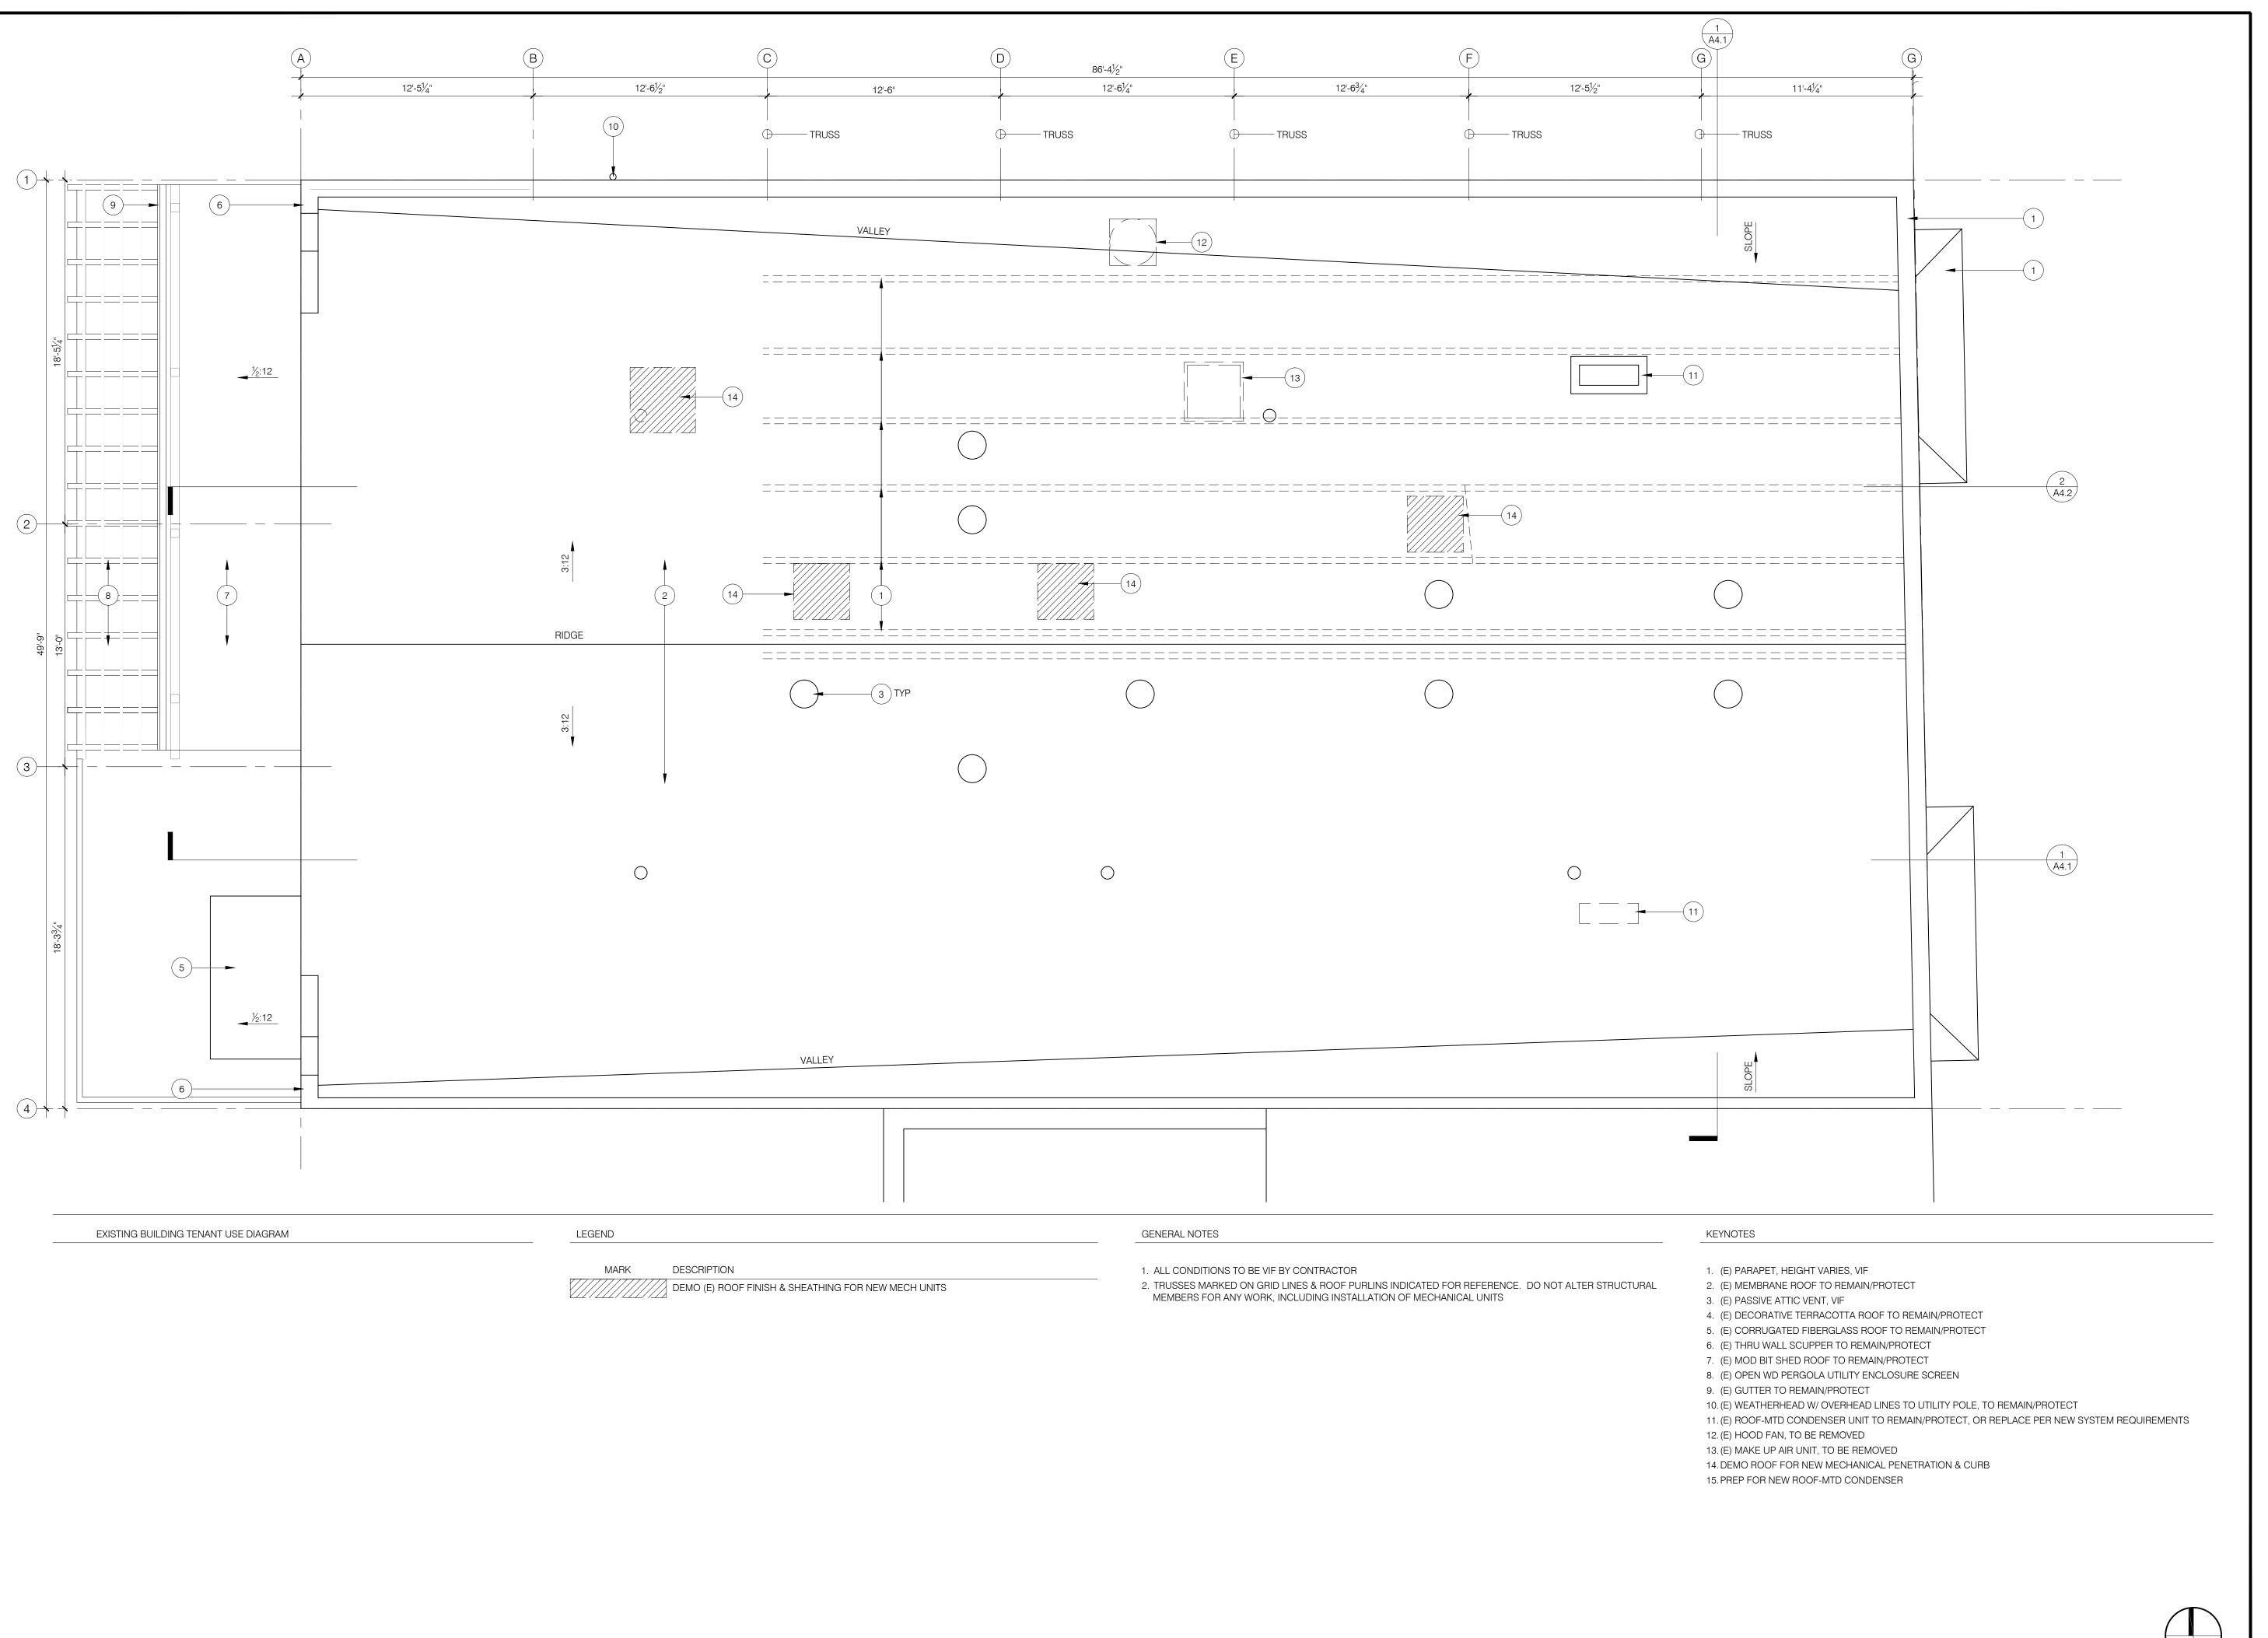



REN. 09-30-21

PROJECT SPONSOR
Station House Cafe
attn: Sheryl Cahill
11285 CA-1
Pt. Reyes Station CA 94956
cell: (707) 477-5496
email: sheryl@stationhousecafe.com

ARCHITECT
Fluid Studios, LLP
Attn: Andrew Davis
PO Box 167
Forest Knolls, CA 94933
415.250.1855
andrew@fluid-studios.com

1 2021.04.16 - USE PERMIT COMMENTS

11285 CA-1
PT REYES STATION
CA 94952
APN 119-226-01

TENANT IMPROVEMENTS


NOT FOR CONSTRUCTION

SCALE: 1/4" = 1'-0"

= 1'-0" SHEET

ROOF DEMO PLAN

A2.4

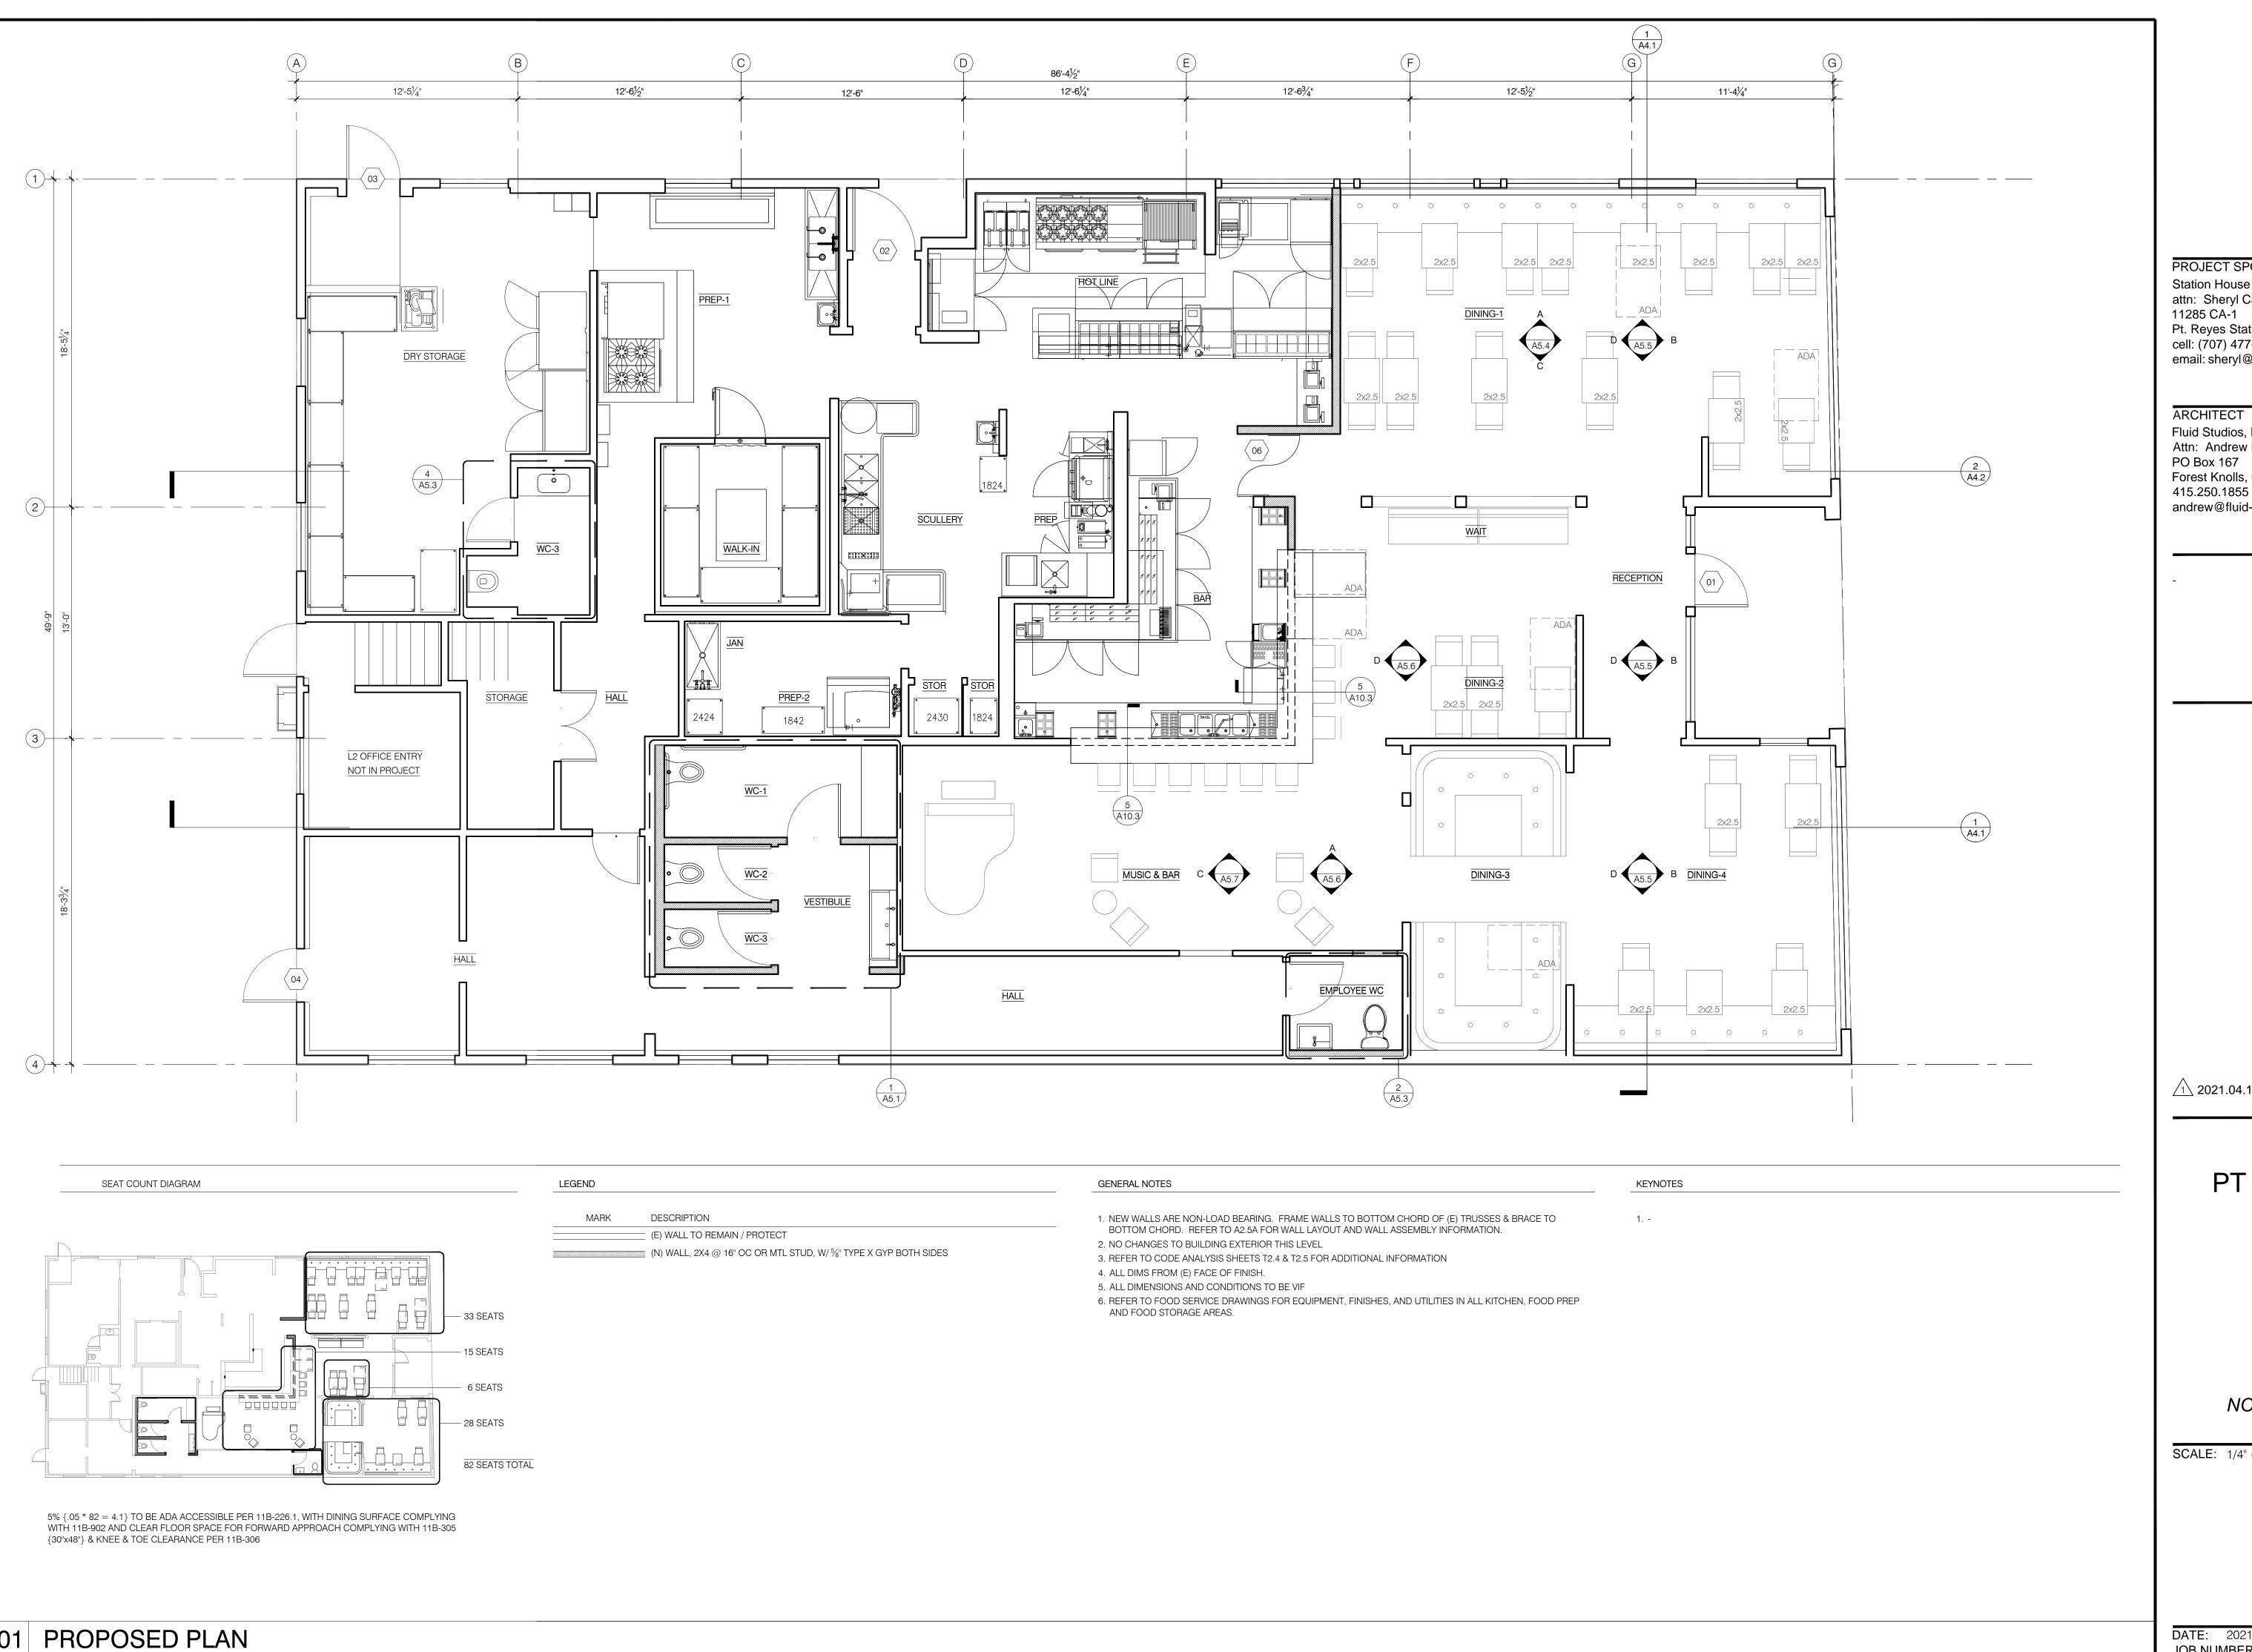

FLUID STUDIOS LLP PO BOX 167 FOREST KNOLLS CA 94933

PROJECT SPONSOR Station House Cafe attn: Sheryl Cahill Pt. Reyes Station CA 94956 cell: (707) 477-5496 email: sheryl@stationhousecafe.com

Fluid Studios, LLP Attn: Andrew Davis PO Box 167 Forest Knolls, CA 94933 415.250.1855 andrew@fluid-studios.com

2021.04.16 - USE PERMIT COMMENTS


11285 CA-1 PT REYES STATION CA 94952 APN 119-226-01

> **TENANT IMPROVEMENTS**

NOT FOR CONSTRUCTION

SCALE: 1/4" = 1'-0"

L1 NEW PLAN

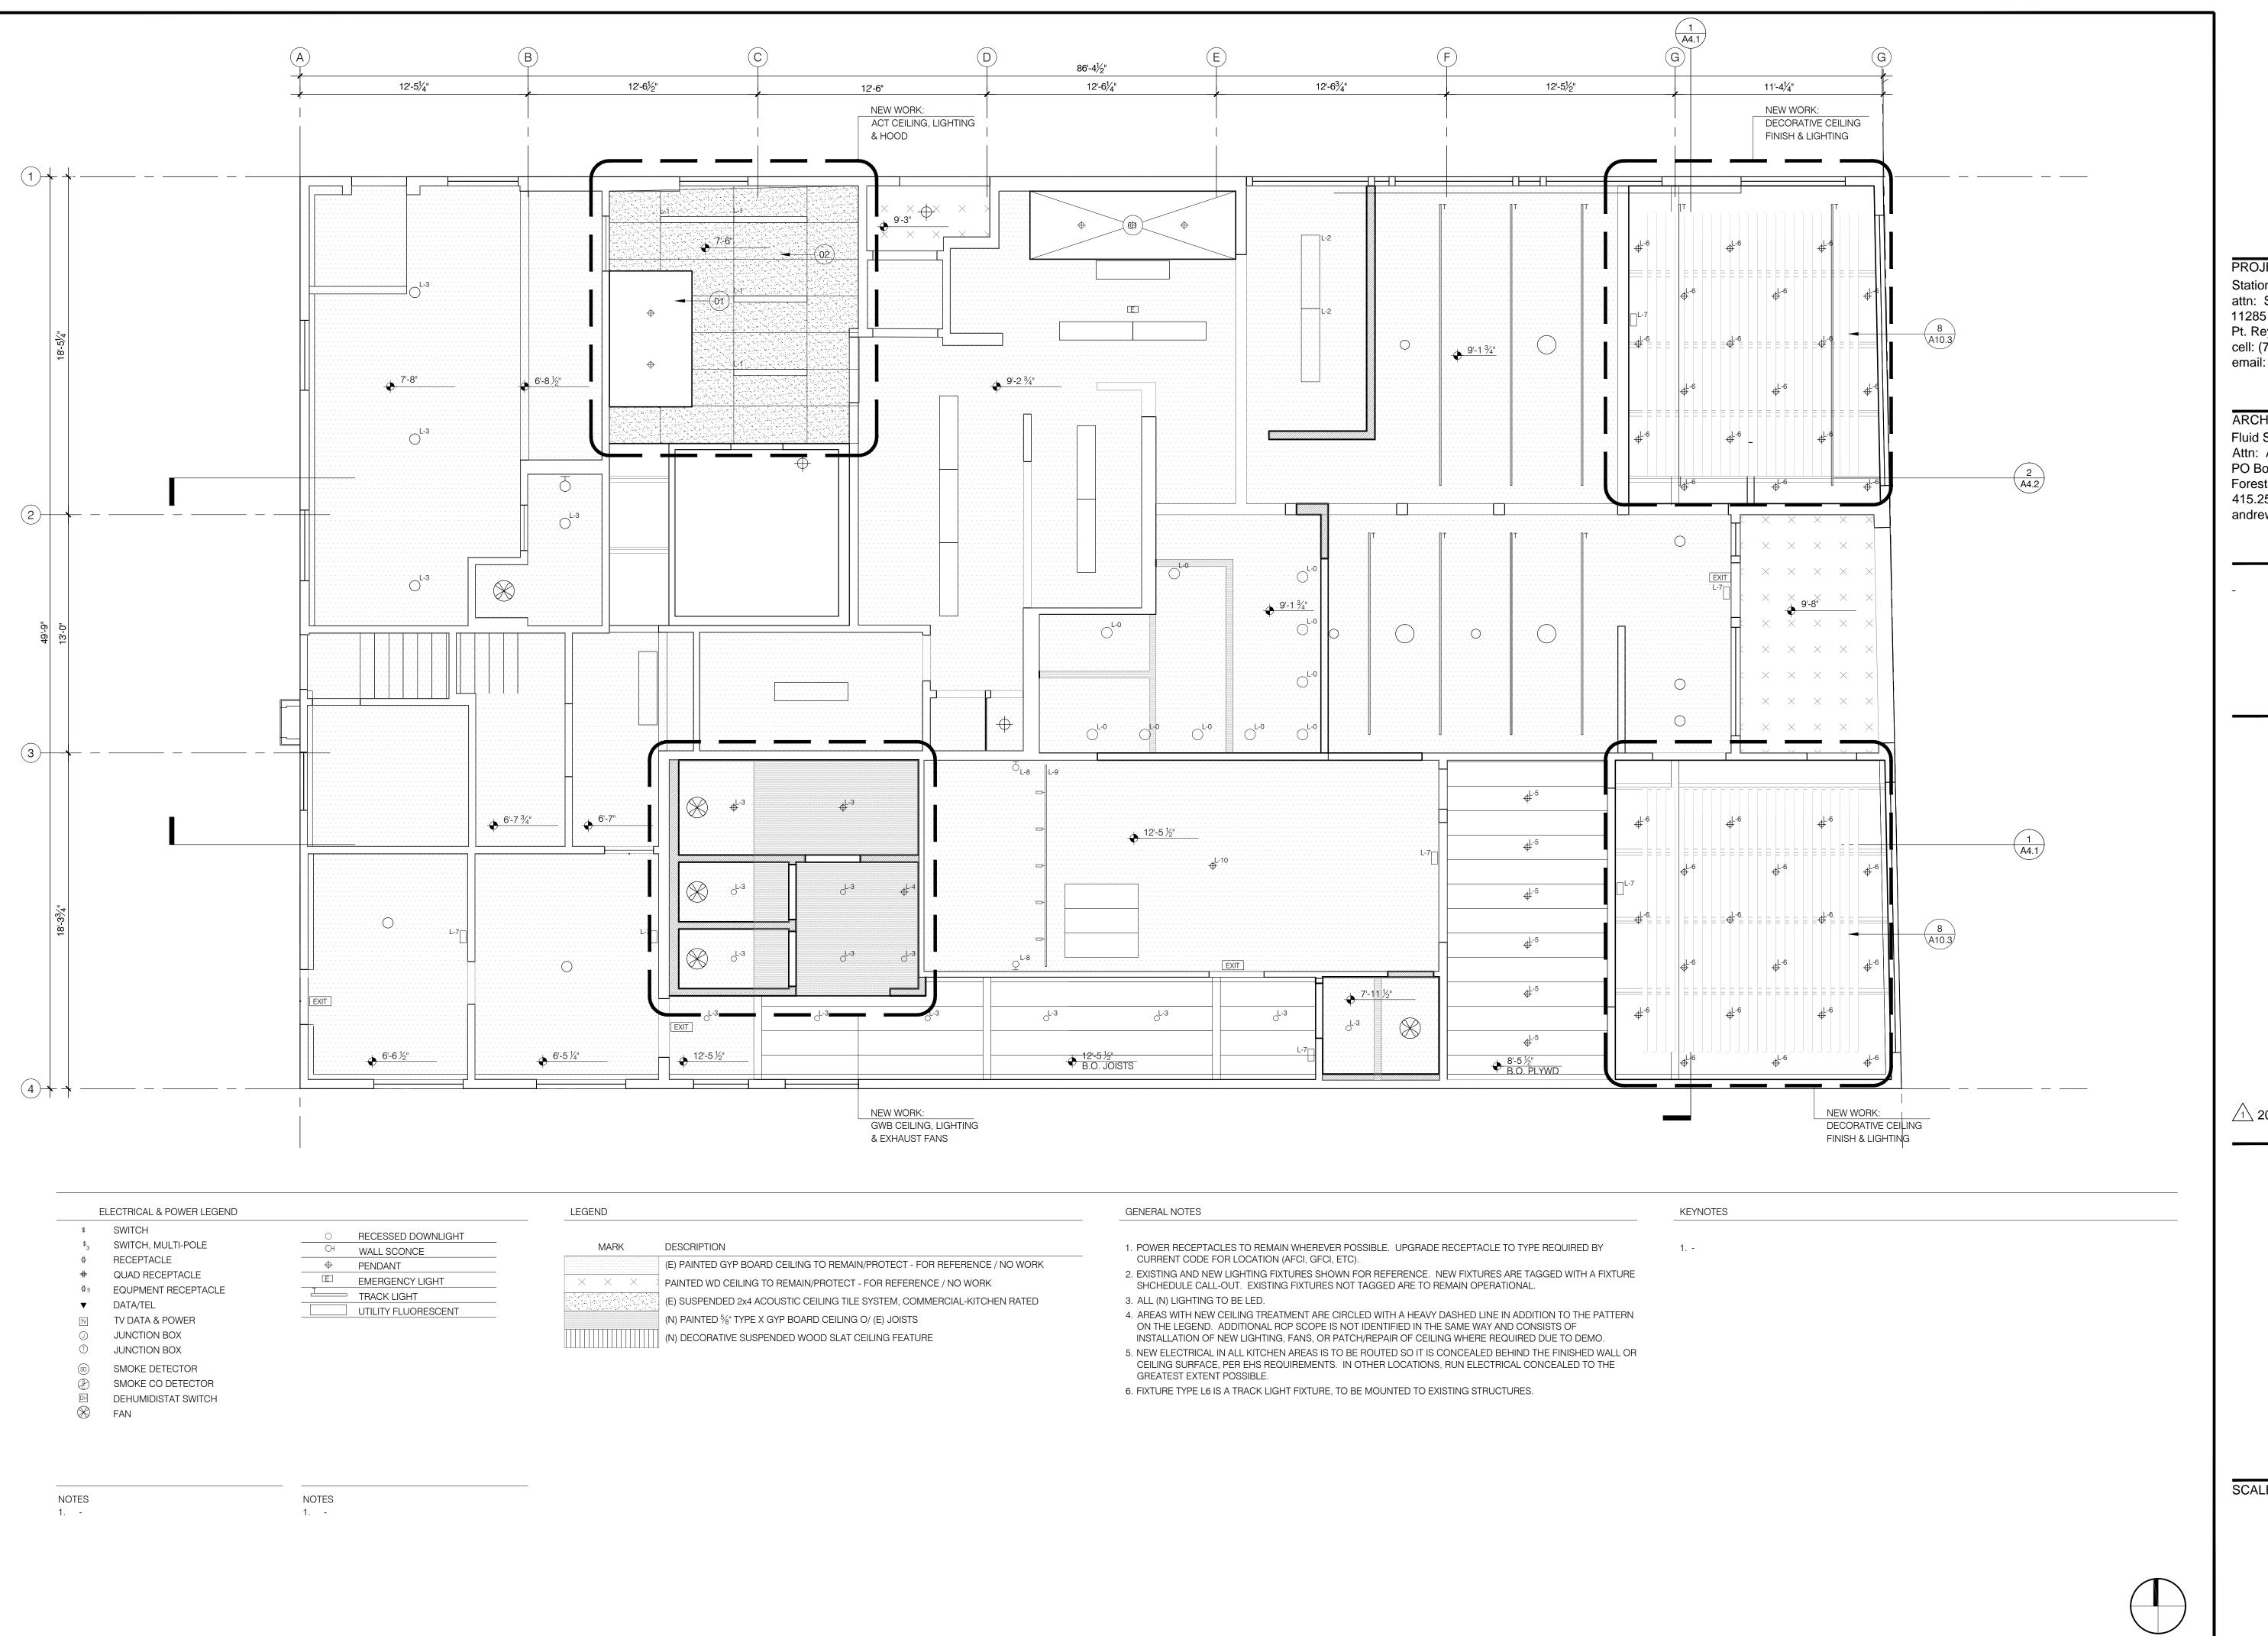

FLUID STUDIOS LLP
PO BOX 167
FOREST KNOLLS

CA 94933

PROJECT SPONSOR
Station House Cafe
attn: Sheryl Cahill
11285 CA-1
Pt. Reyes Station CA 94956
cell: (707) 477-5496
email: sheryl@stationhousecafe.com

ARCHITECT
Fluid Studios, LLP
Attn: Andrew Davis
PO Box 167
Forest Knolls, CA 94933
415.250.1855
andrew@fluid-studios.com

1 2021.04.16 - USE PERMIT COMMENTS

11285 CA-1
PT REYES STATION
CA 94952
APN 119-226-01


TENANT IMPROVEMENTS


NOT FOR CONSTRUCTION

SCALE: 1/4" = 1'-0"


L1 PROPOSED RCP

A2.6

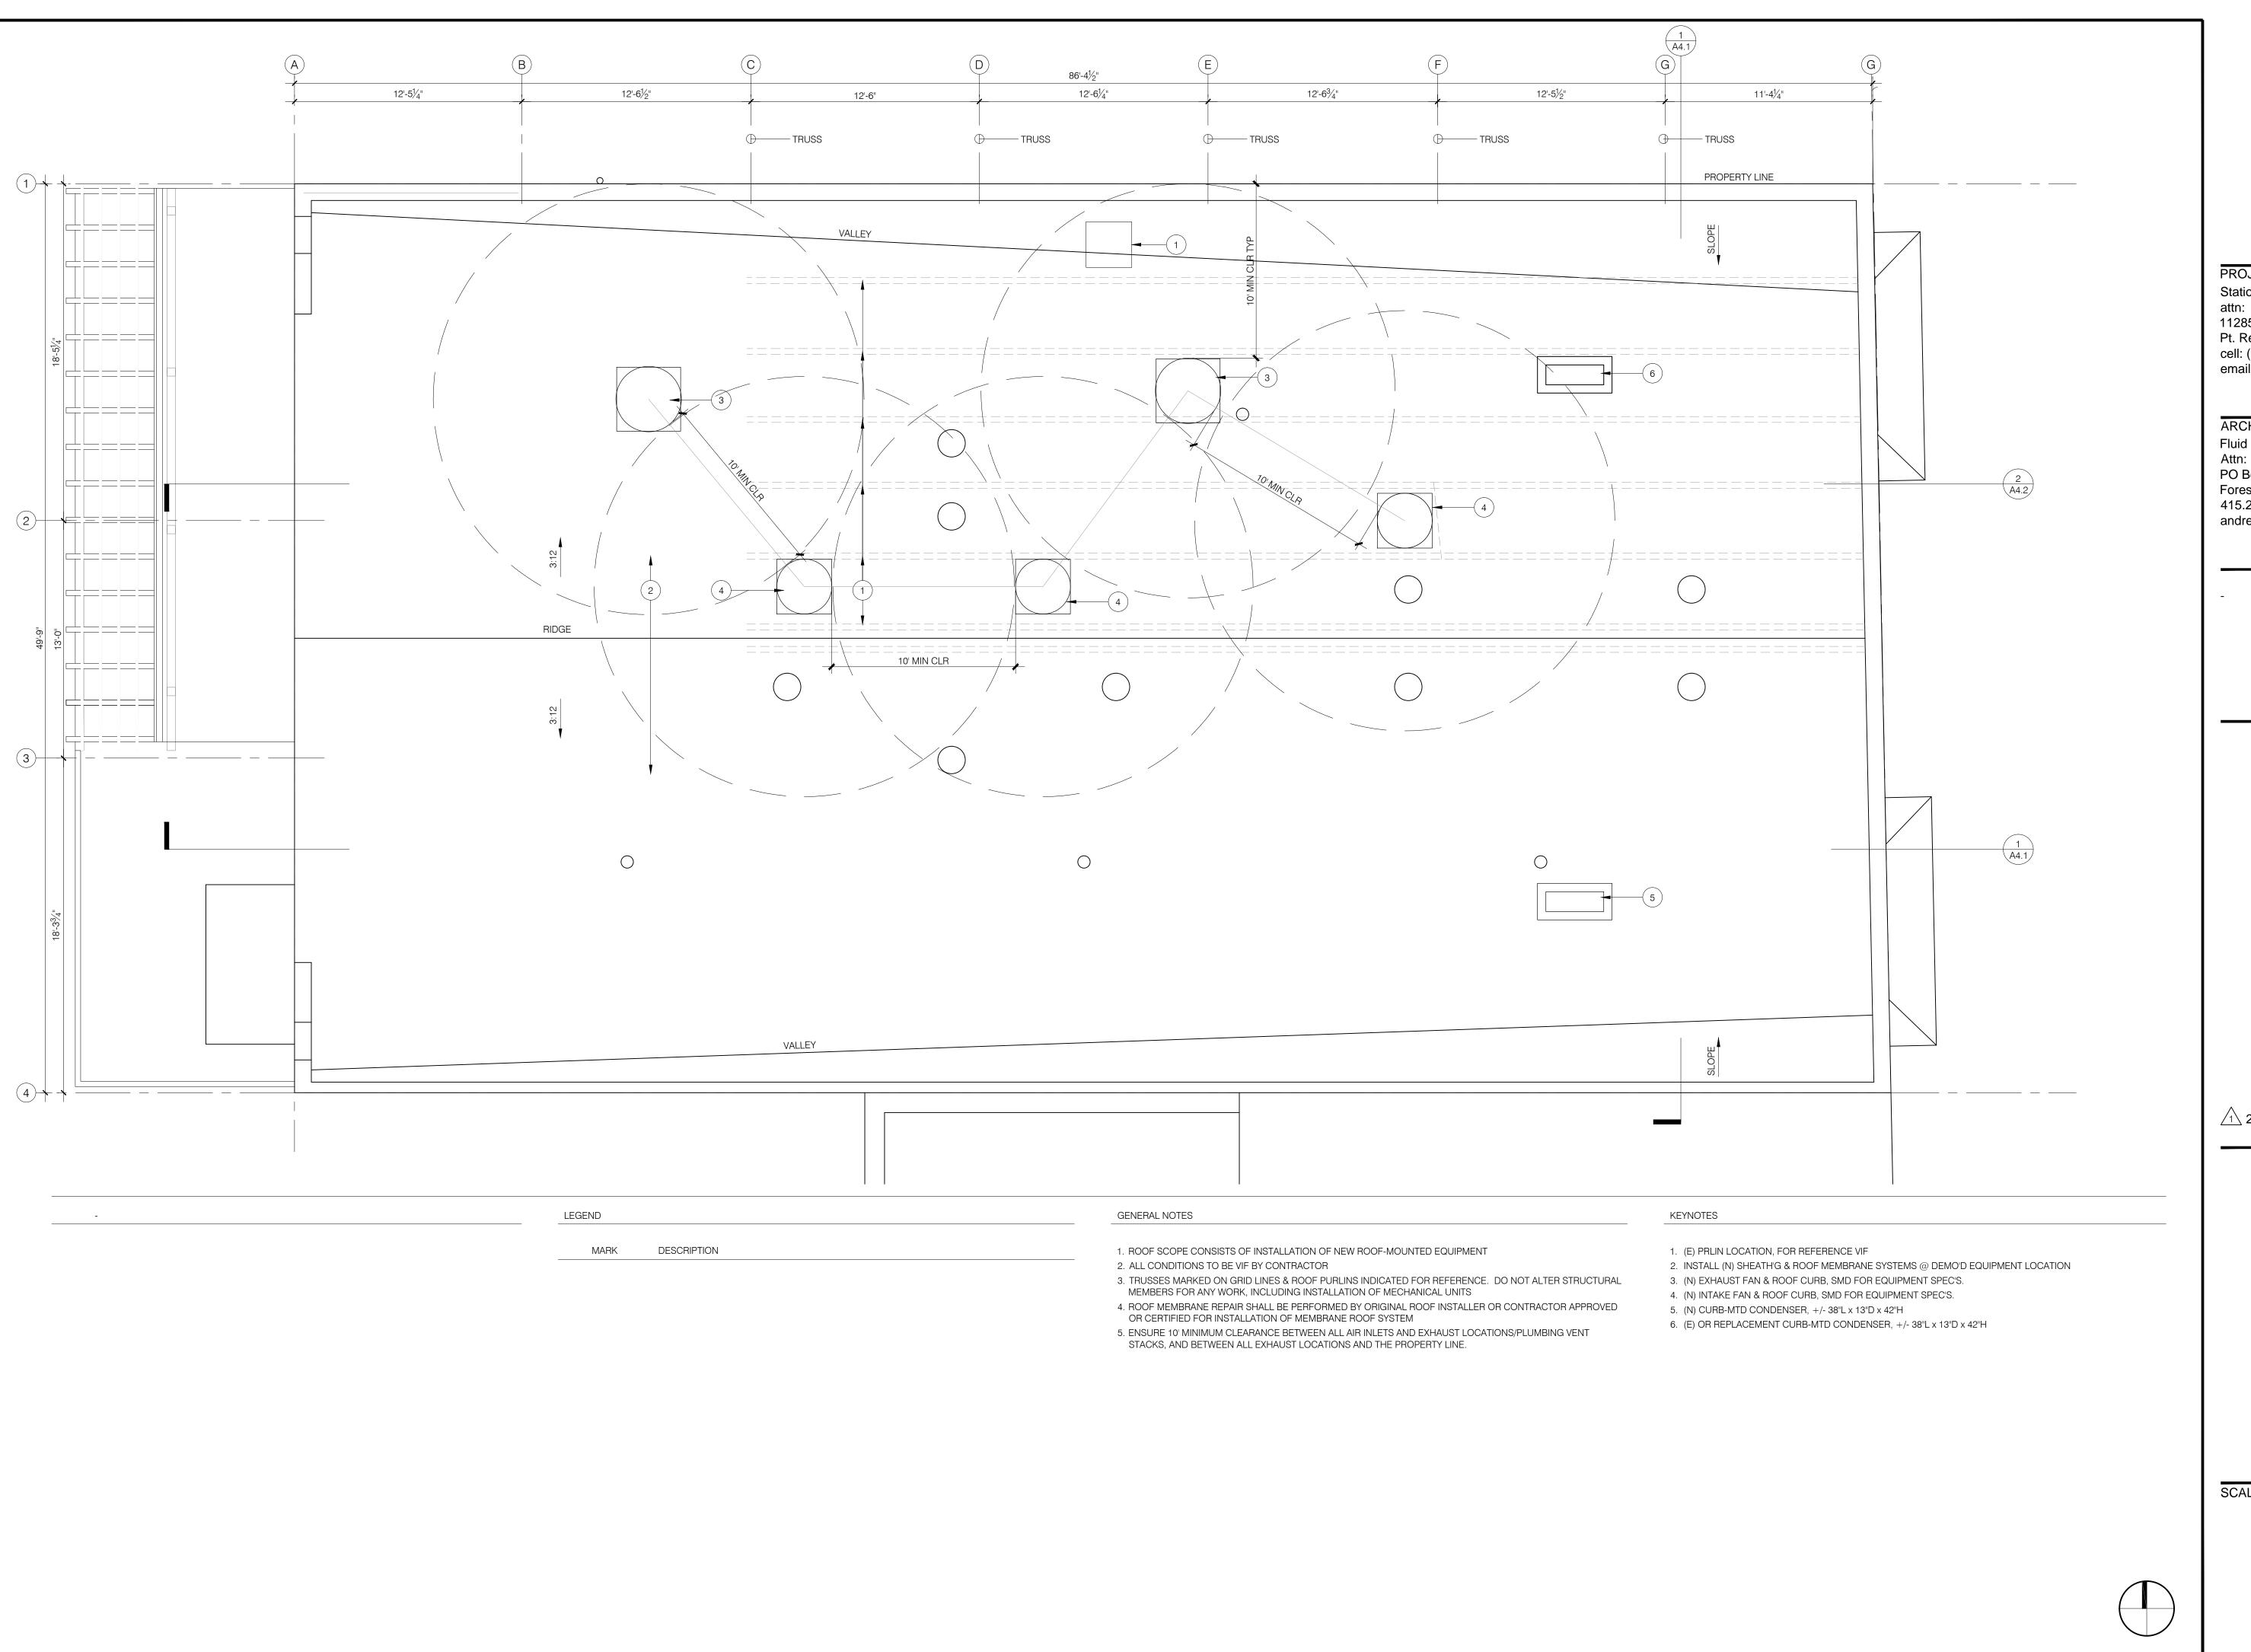

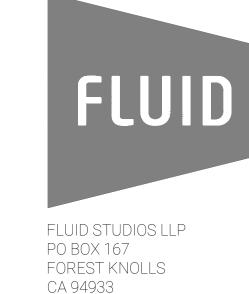

ARCHITECT
Fluid Studios, LLP
Attn: Andrew Davis
PO Box 167
Forest Knolls, CA 94933
415.250.1855
andrew@fluid-studios.com

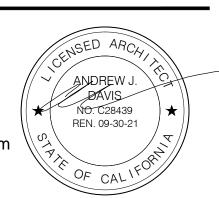

2021.04.16 - USE PERMIT COMMENTS

11285 CA-1
PT REYES STATION
CA 94952
APN 119-226-01

TENANT IMPROVEMENTS


NOT FOR CONSTRUCTION

SCALE: 1/4" = 1'-0"

NEW ROOF PLAN


A2.7

01 NEW ROOF PLAN

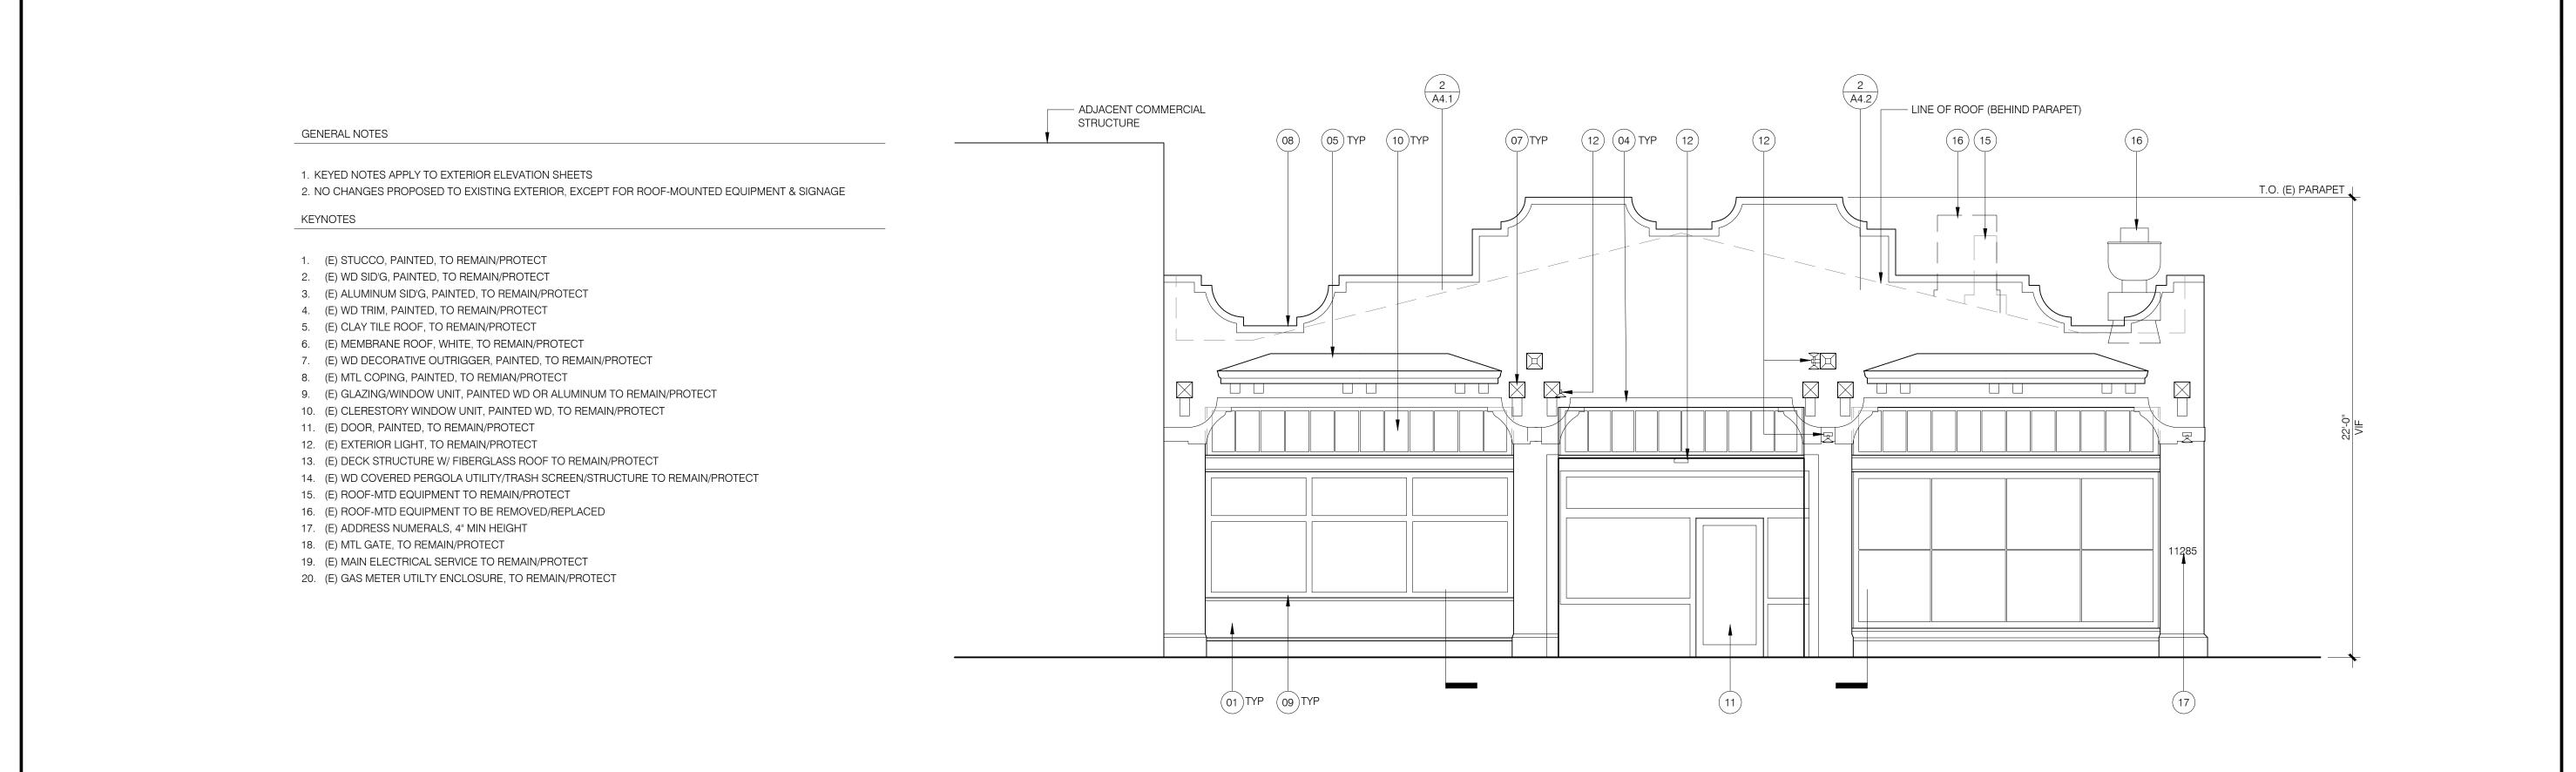




ARCHITECT
Fluid Studios, LLP
Attn: Andrew Davis
PO Box 167
Forest Knolls, CA 94933
415.250.1855
andrew@fluid-studios.com

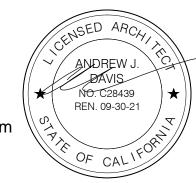

1 EAST / CA-1 ELEVATION

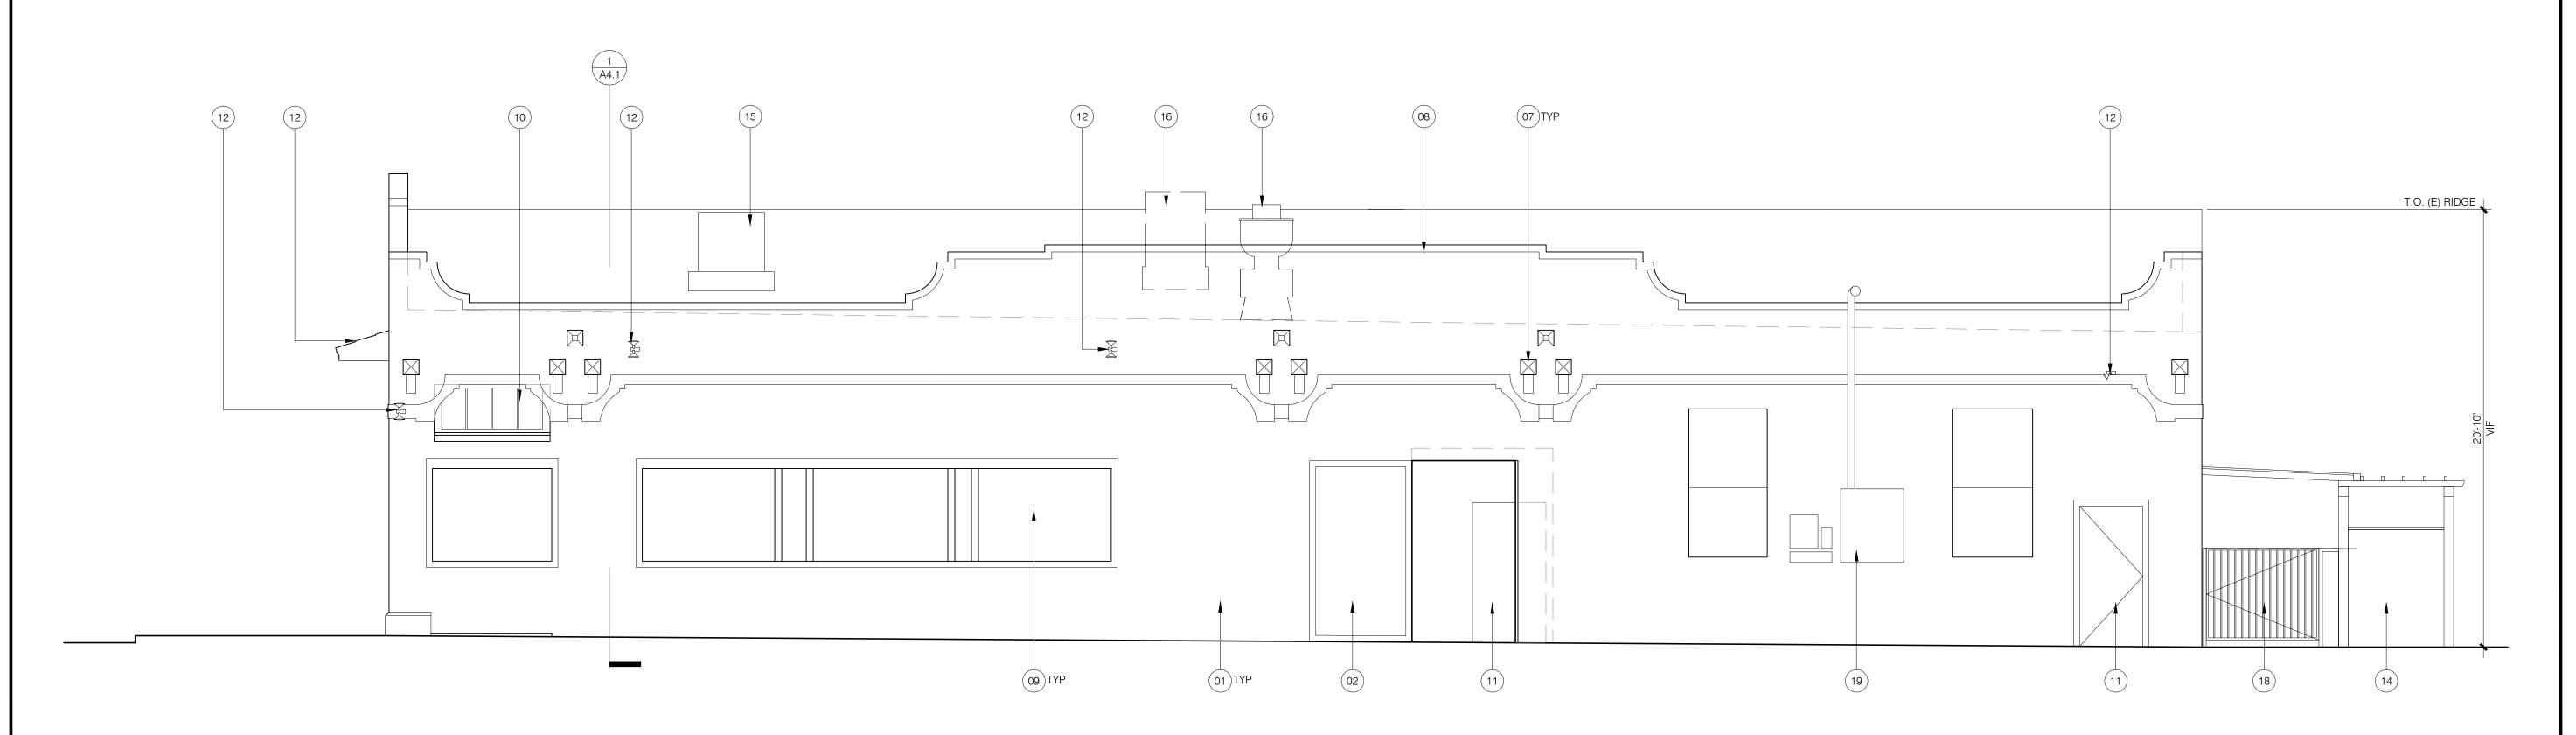

1 2021.04.16 - USE PERMIT COMMENTS

11285 CA-1
PT REYES STATION
CA 94952
APN 119-226-01

TENANT IMPROVEMENTS


NOT FOR CONSTRUCTION

SCALE: 1/4" = 1'-0"

EXISTING EXTERIOR

ELEVATIONS

A3.1

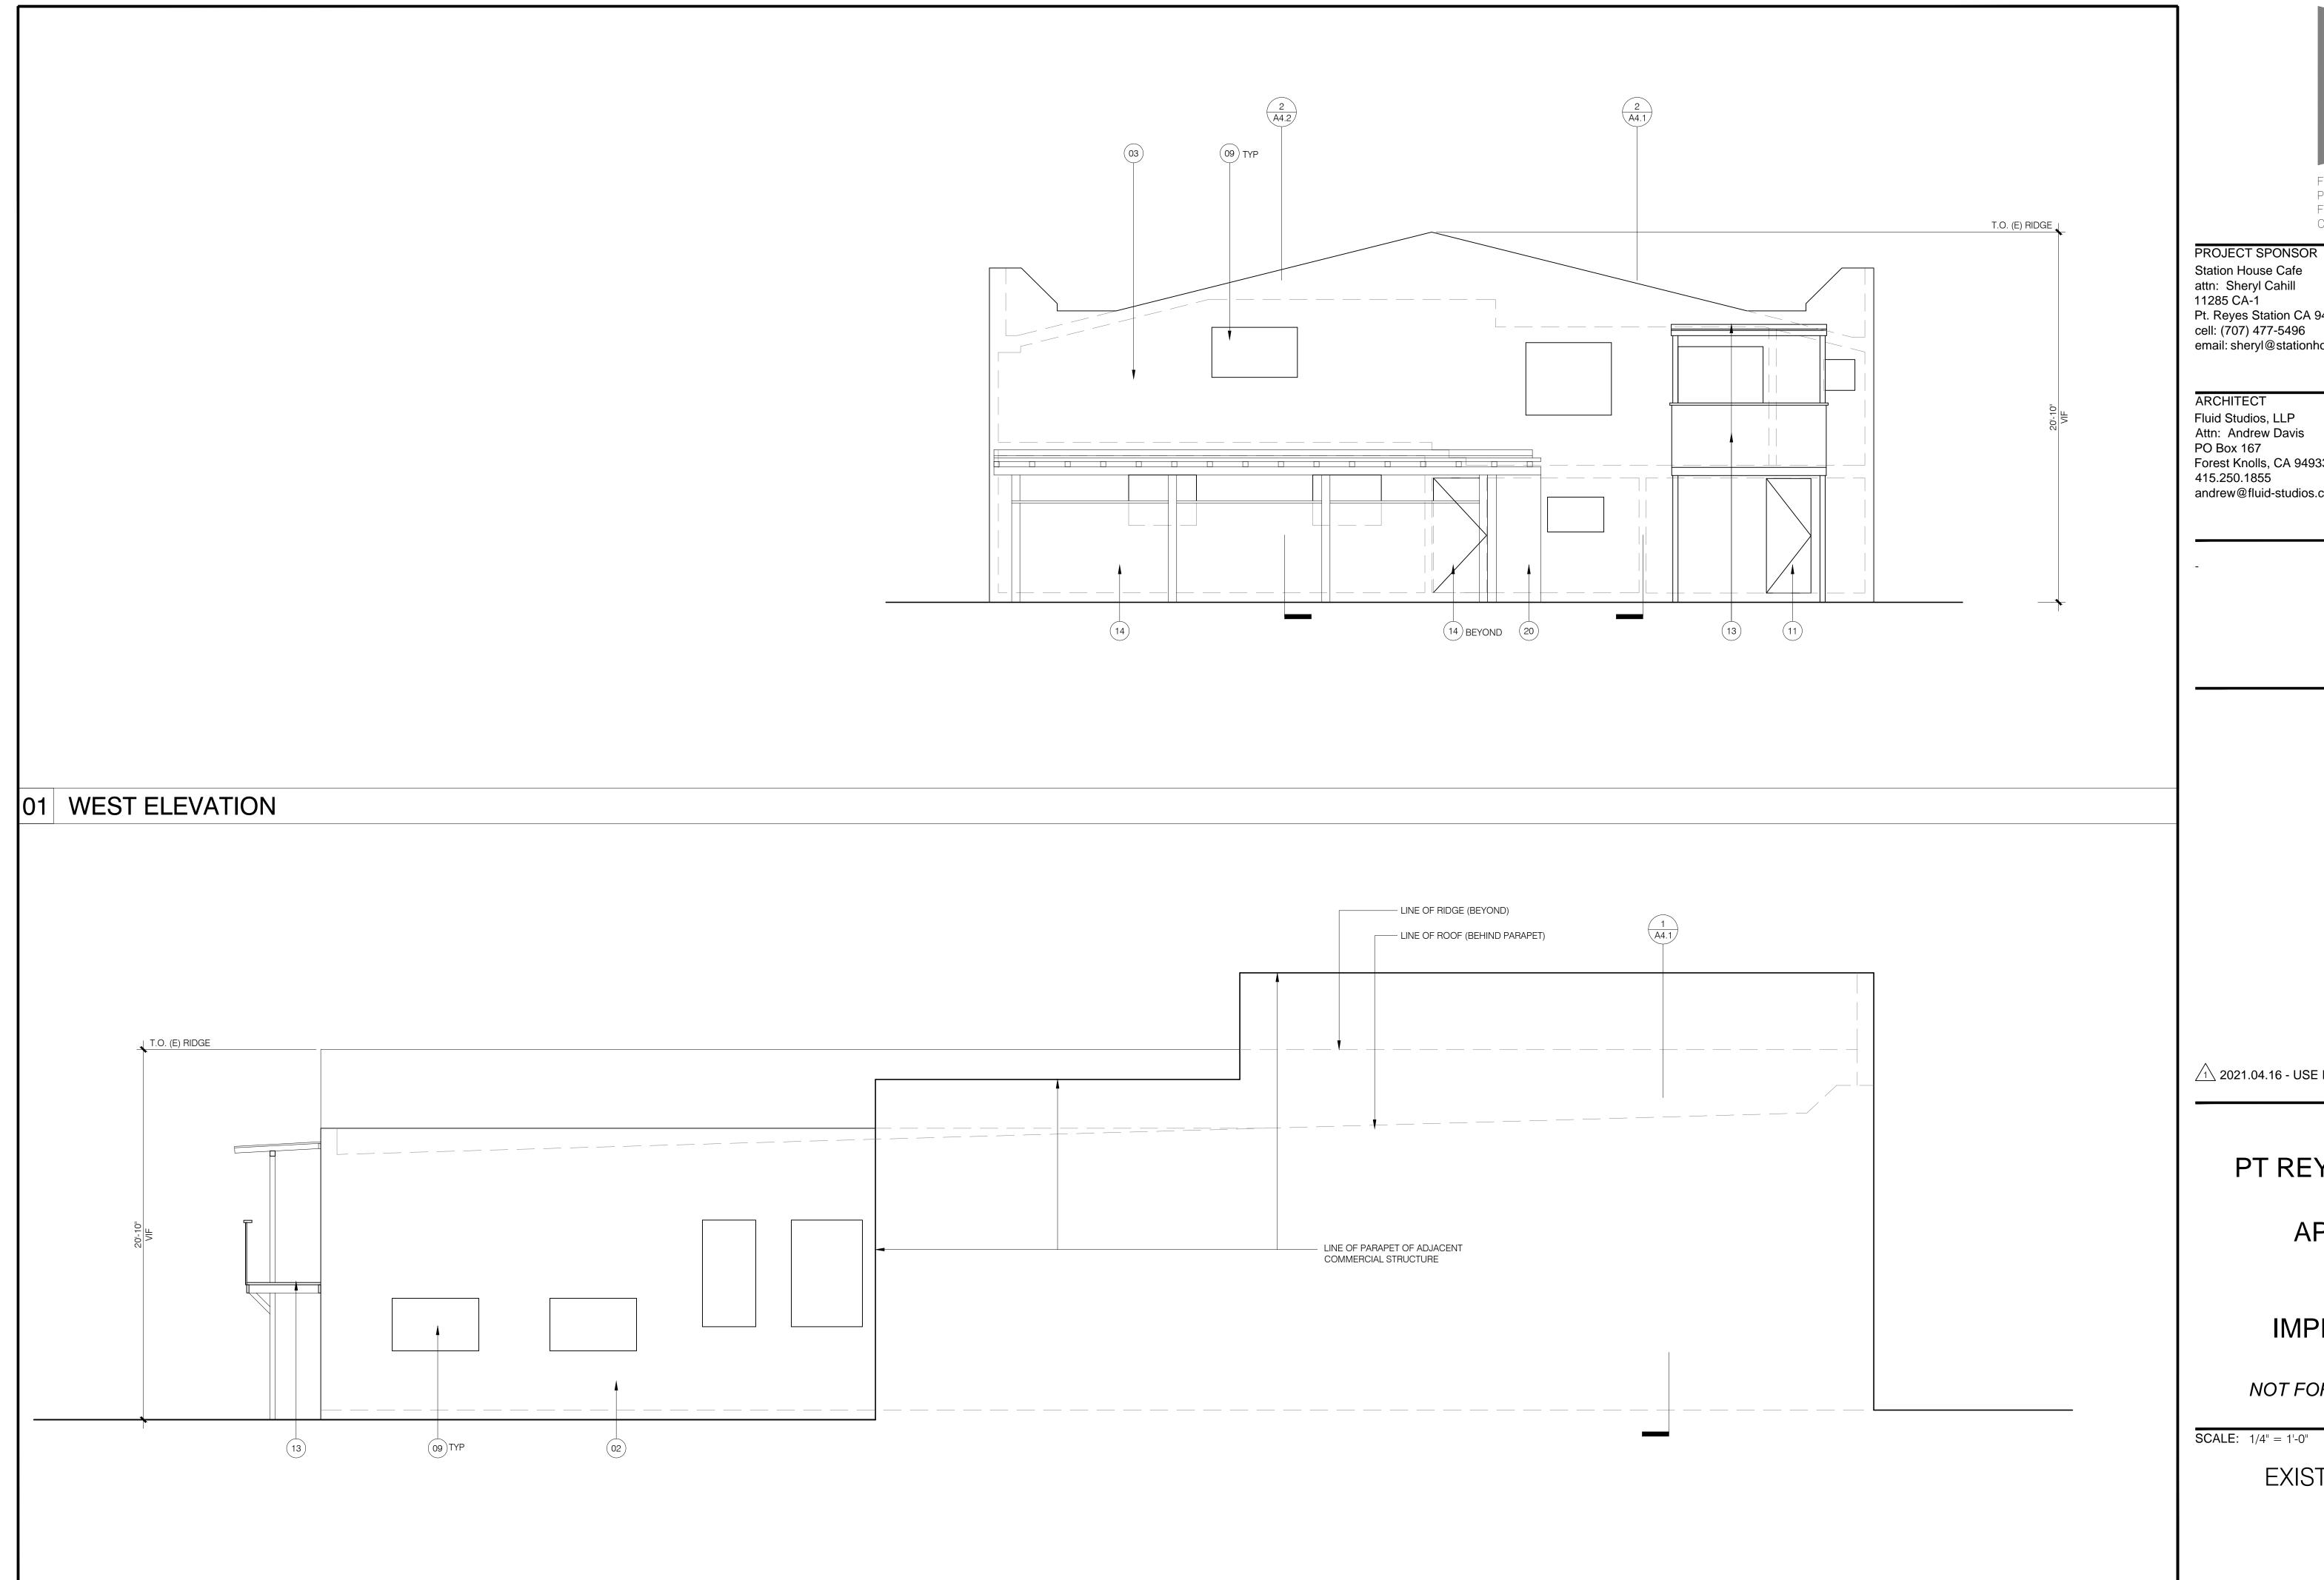

02 SOUTH ELEVATION

FLUID STUDIOS LLP PO BOX 167 FOREST KNOLLS CA 94933

Pt. Reyes Station CA 94956 cell: (707) 477-5496 email: sheryl@stationhousecafe.com

Forest Knolls, CA 94933 andrew@fluid-studios.com


2021.04.16 - USE PERMIT COMMENTS


11285 CA-1 PT REYES STATION CA 94952 APN 119-226-01

> **TENANT IMPROVEMENTS**

NOT FOR CONSTRUCTION

EXISTING EXTERIOR ELEVATIONS

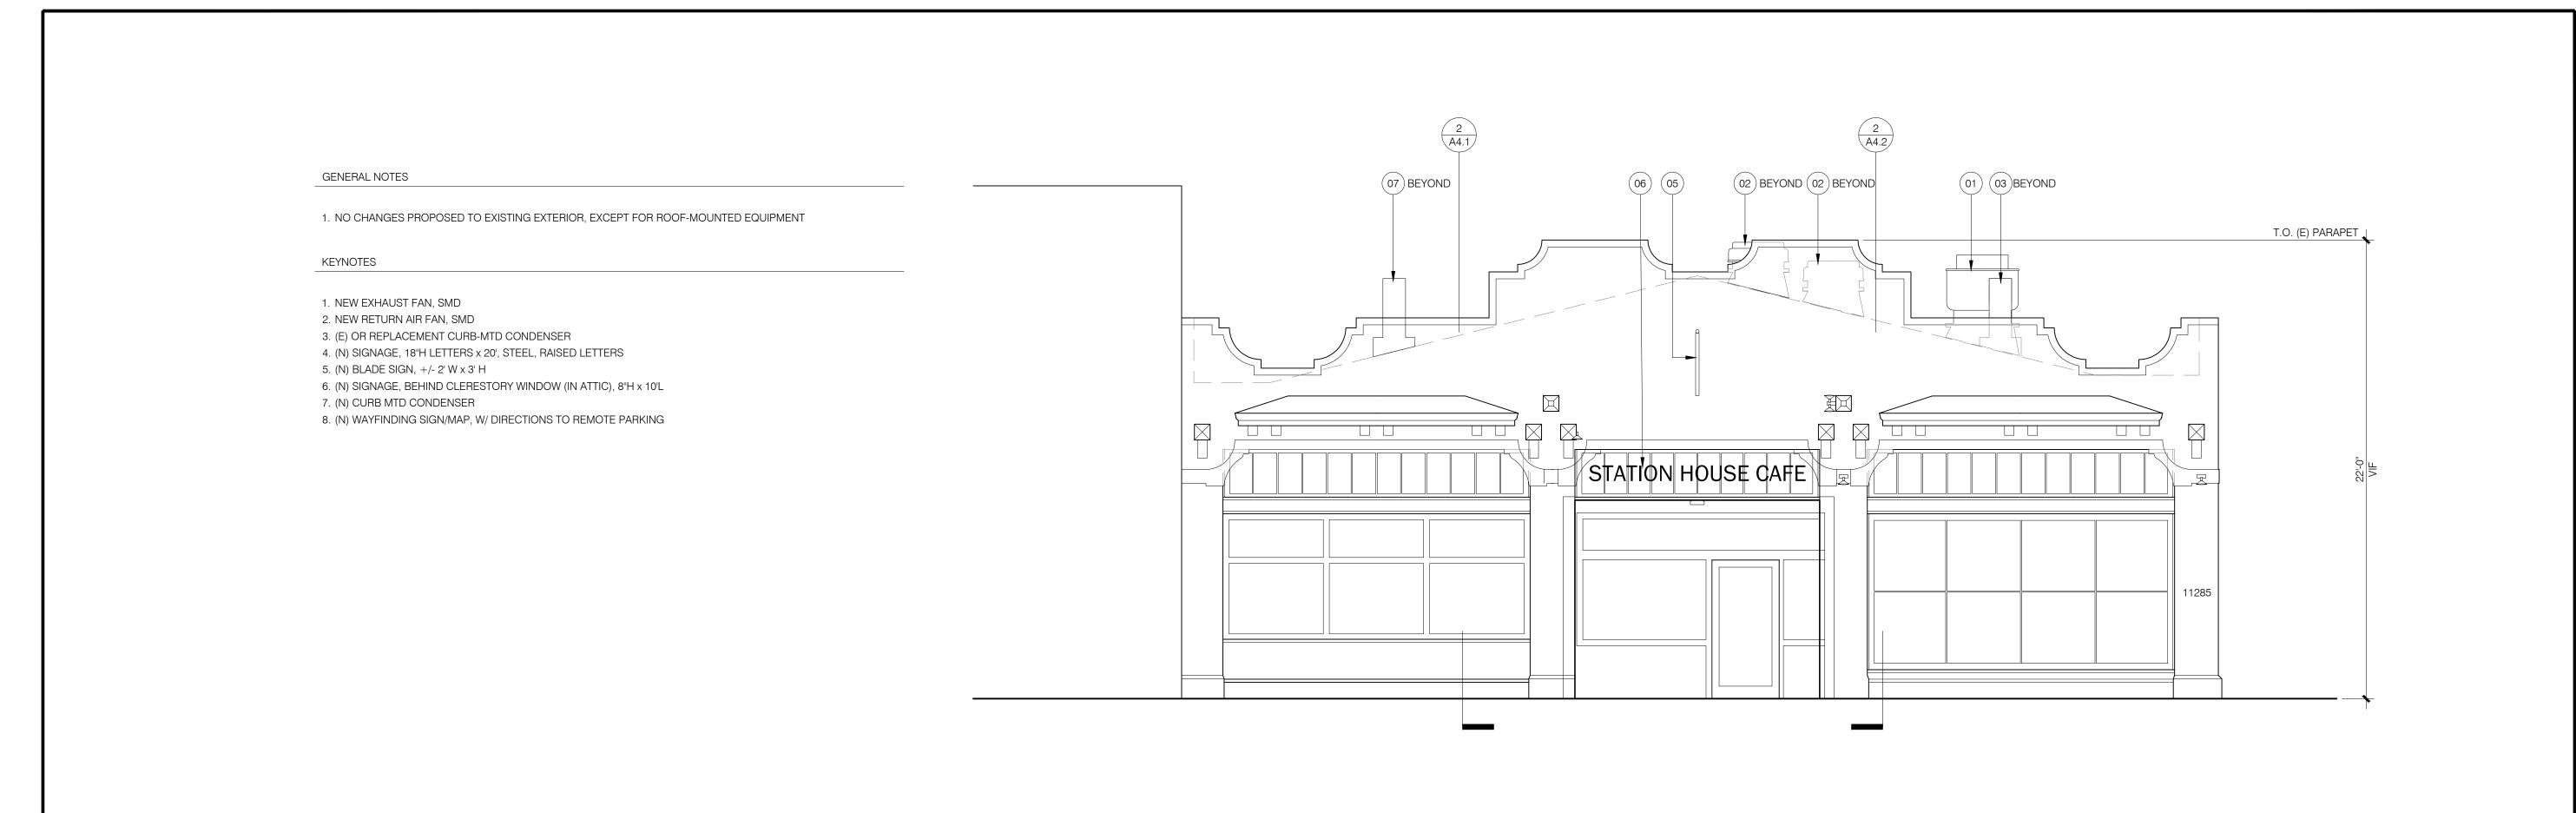


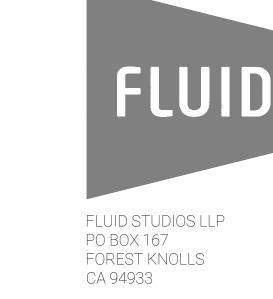

ARCHITECT Fluid Studios, LLP Attn: Andrew Davis PO Box 167 Forest Knolls, CA 94933 415.250.1855 andrew@fluid-studios.com



NEW EAST / CA-1 ELEVATION

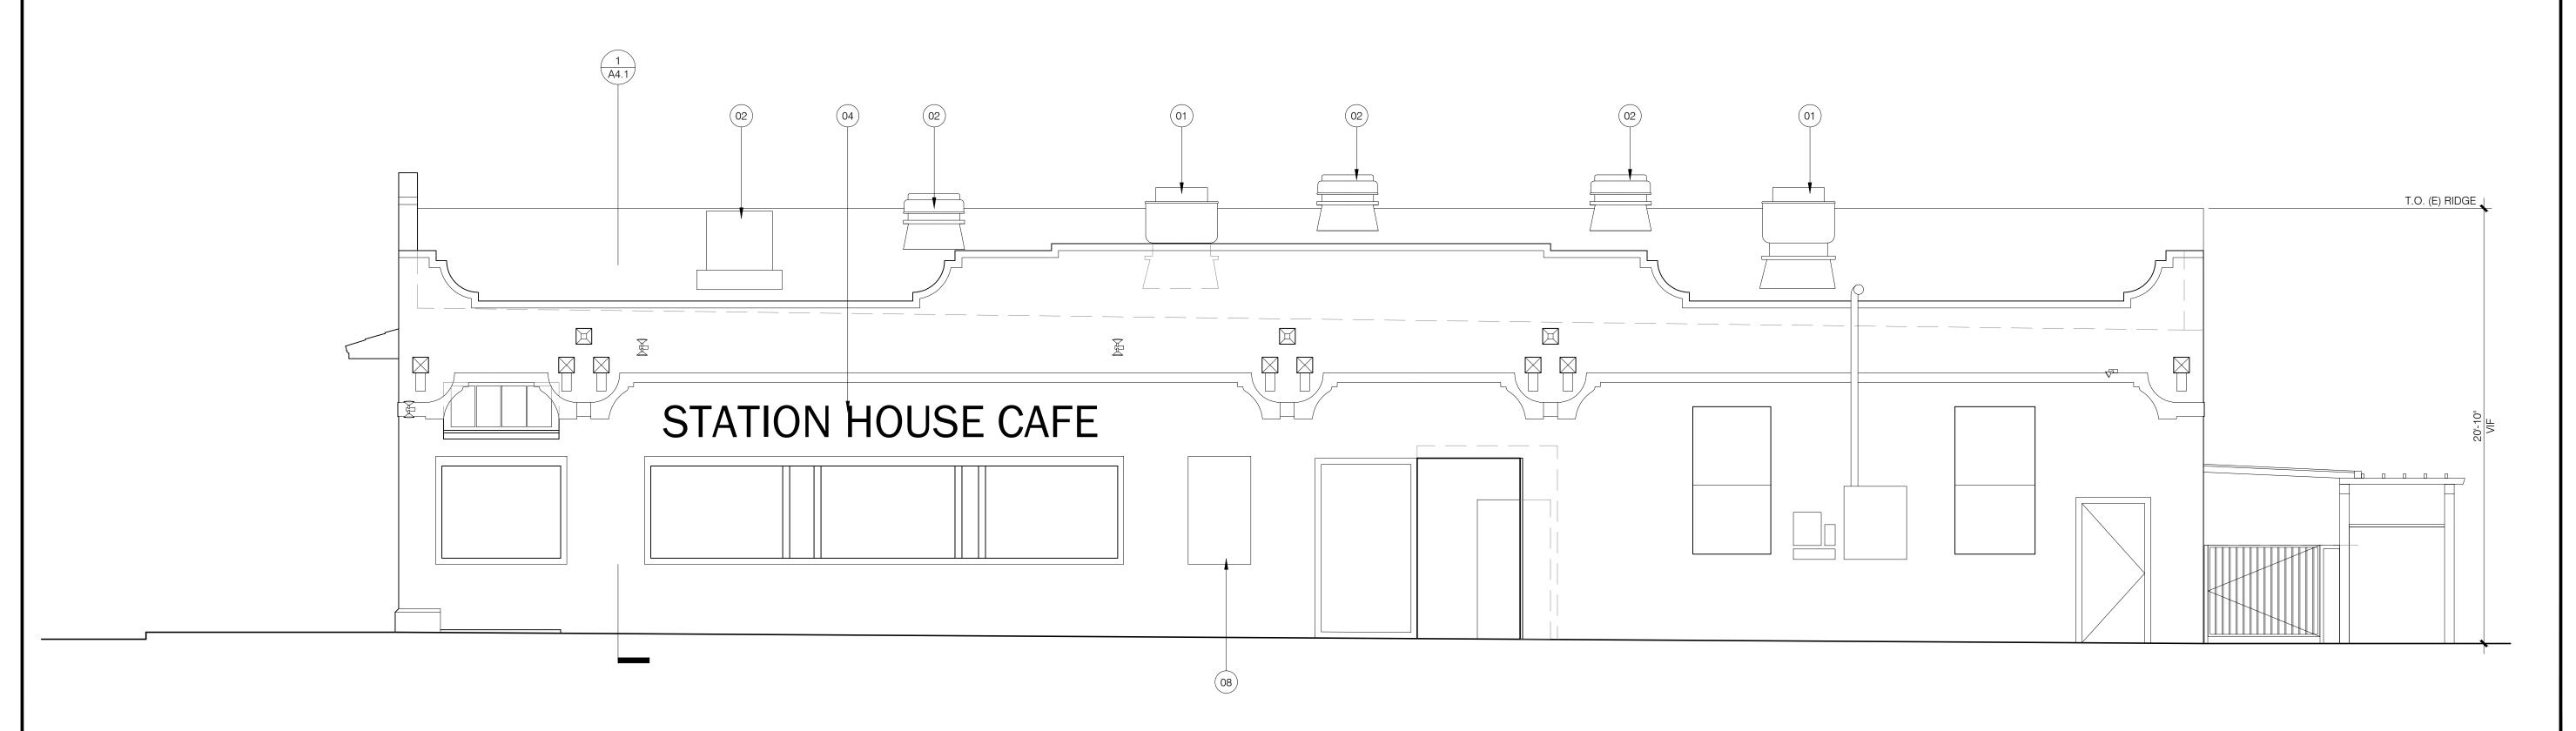

2021.04.16 - USE PERMIT COMMENTS

11285 CA-1 PT REYES STATION CA 94952 APN 119-226-01


> **TENANT IMPROVEMENTS**

NOT FOR CONSTRUCTION

SCALE: 1/4" = 1'-0"


NEW EXTERIOR ELEVATIONS

02 NEW NORTH / 3RD STREET ELEVATION

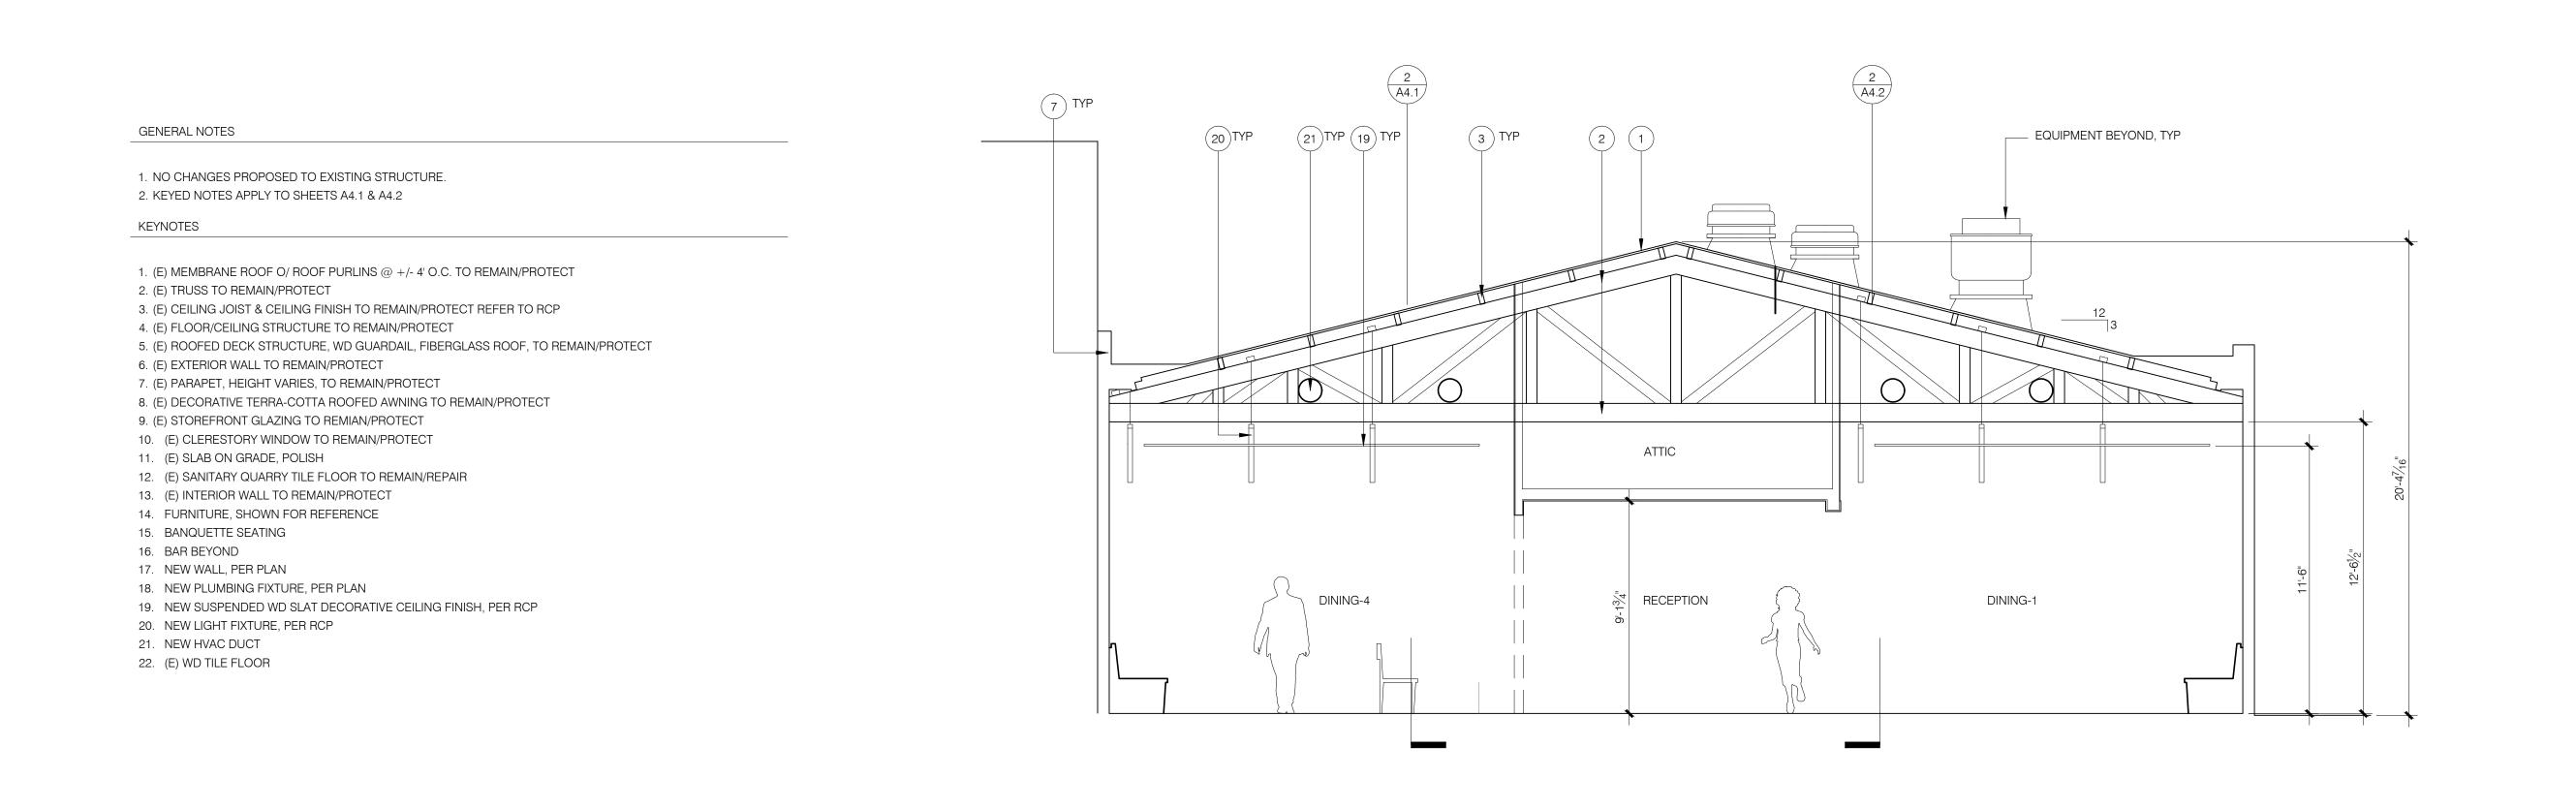




ARCHITECT
Fluid Studios, LLP
Attn: Andrew Davis
PO Box 167
Forest Knolls, CA 94933
415.250.1855
andrew@fluid-studios.com

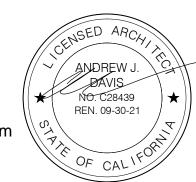

CROSS SECTION

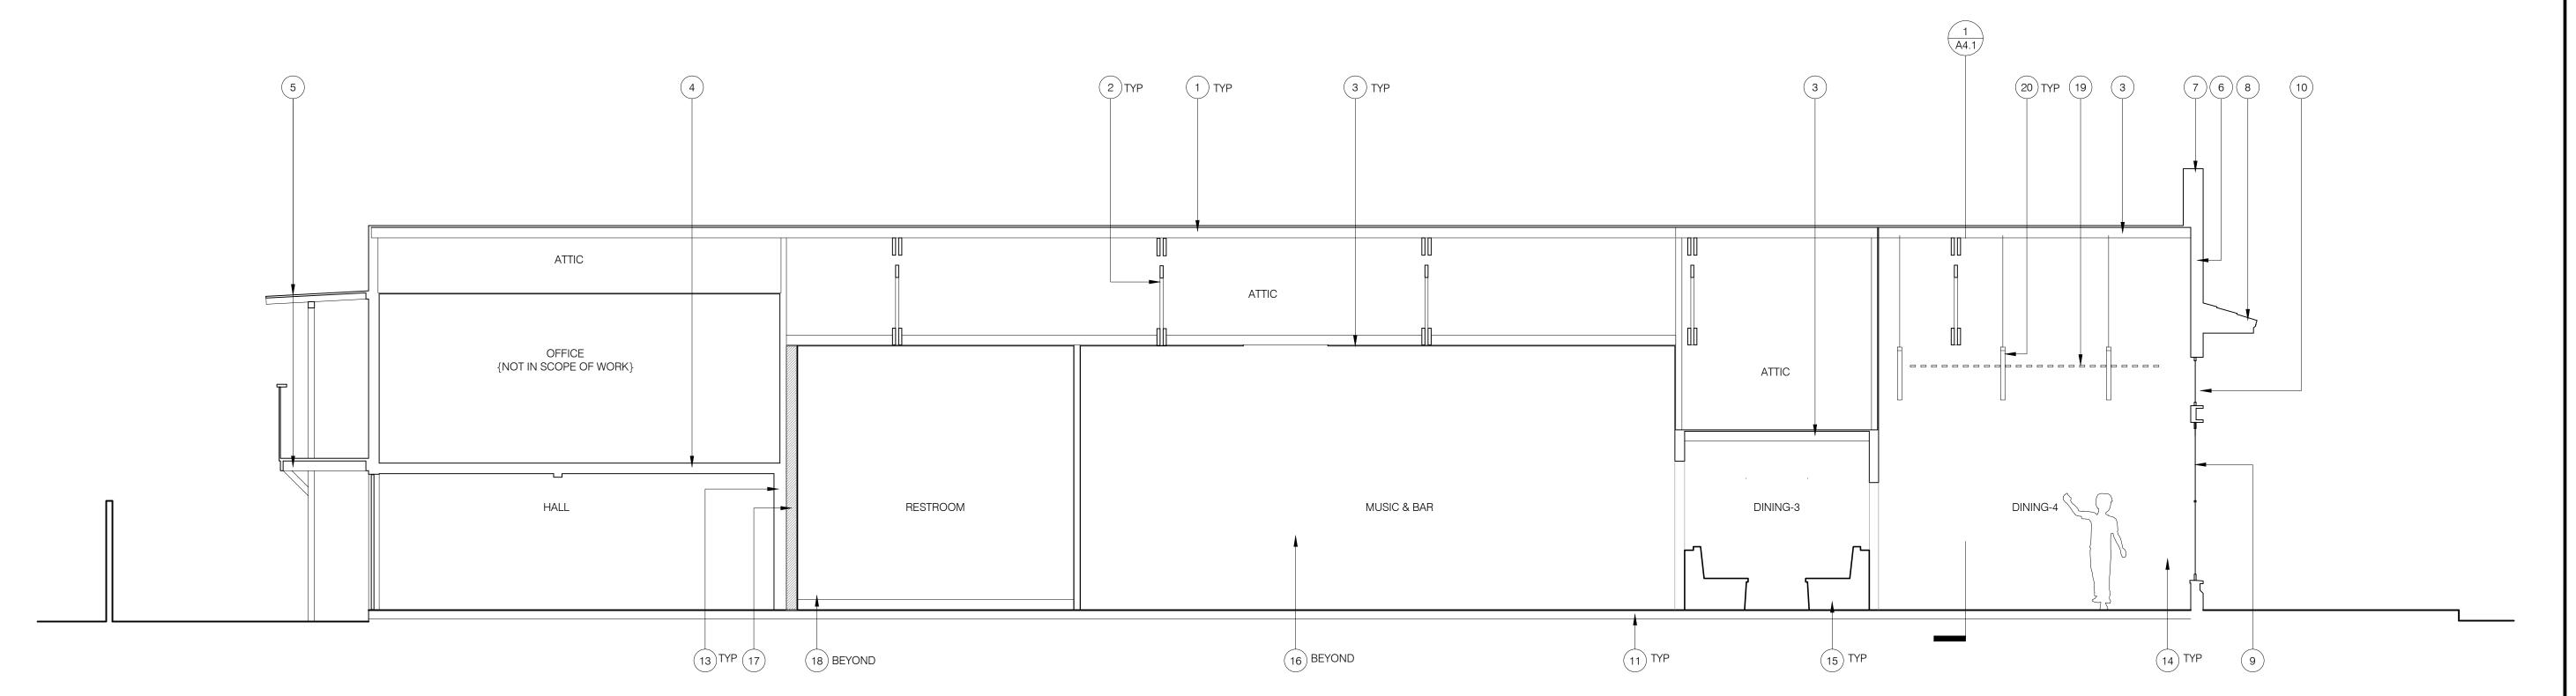

1 2021.04.16 - USE PERMIT COMMENTS

11285 CA-1
PT REYES STATION
CA 94952
APN 119-226-01

TENANT IMPROVEMENTS

NOT FOR CONSTRUCTION

SCALE: 1/4" = 1'-0"

BUILDING SECTIONS

A4.1

DATE: 2021.04.16 JOB NUMBER: 2027

02 LONG SECTION



02 LONG SECTION



PO BOX 167 FOREST KNOLLS CA 94933

Pt. Reyes Station CA 94956 cell: (707) 477-5496 email: sheryl@stationhousecafe.com

Forest Knolls, CA 94933 andrew@fluid-studios.com

NO. C28439 REN. 09-30-21

2021.04.16 - USE PERMIT COMMENTS

11285 CA-1 PT REYES STATION CA 94952 APN 119-226-01

> **TENANT IMPROVEMENTS**

NOT FOR CONSTRUCTION

BUILDING SECTIONS