# **CORNER RECORD**

			Document I	Number <u>/</u>	APIN 034-202	-10
City of Tiburon		_ (	County of	Marin		, California
Brief Legal Descri	ption Lot 107 - 7 RM 13					
	CODMED	D/DE			0000000	~~
	CORNER 1	YPE			OORDINATE	,
	Government Corner	Control				
	Meander	Property	Ø	Zone	1	NAD27 NAD83
	Rancho	Other		NAD83 Epoc		
				Elev.		·
	Date of Survey May 15,	2015		Vert. Datum:	NGVD29	NADV88
				Meas. Units:	Metric	Imperial
Corner - Left a	s found 🗹 Found and tagged	I 🗌 E	stablished 🗹	Rees	tablished	Rebuilt
Identification and type	of corner found: Evidence used to ide	entify or oro	redure used t	to establish o	r roostablish th	A COMO C
	n pipes in mounument well, v					
	ce between of 295.29', calcula					
				5 Dasis UI	bearings in	'I
survey taken as 5	43°48'16" W as calculated from	7 RM 13.				
		***		w <del>a</del>		
A description of the ph	sysical condition of the monument as	found and a	e set or reset	Found re	cord monu	ments(4) at
	13, and record monuments(2					
			<del></del>	···		
	11 as shown on Exhibit A, Pag					
	", and brass nail and brass ta	g(1) stam	ipea with "I	RCE 1822	1" on prope	rty lines as
shown on Exhibit	A, Page 2 of 2.				· · · · · · · · · · · · · · · · · · ·	
	SURVEYOR'S STATEM	IENT			p <sup>d</sup> .	COURS SON
						\$\\\\\\\\\\\\\\\\\\\\\\\\\\\\\\\\\\\\\
This Corner Record	was prepared by me or under my	direction is	n conforman	ce with	118	度 C 18222 到
the Land Surveyor's A	ct on May 29	201	5 .		R	区 SEML V22 1 7 7 1 1 1 1 1 1 1 1 1 1 1 1 1 1 1 1
	111		10221		1/2	CAP GIOGIZONO
Signed	P.L.S. or F	R.C.E. No.:	18221	<del></del>	- 1	S) CIVIL AND
					*	CF CAUTO
	COUNTY SURVEYOR'S STA	TEMENT			,	
		91	715			RICHARD G. SIMONITCH
This Corner Record w	as received JUNE 5		<u>/  )</u> aı	nd examined		
and filed OUL	17 2015				118/	RICHARD G.
Signad - \	ni s	- D-6-77 N-	. 70	21	1121	No. 7821 / X
Signed		r.R.C.E. No	/	<i>'                                    </i>	- \\\\ <u>\</u> \\\\\\\\\	
Title County	Surveyor					
County Surveyor's	Comment	· · · · · · · · · · · · · · · · · · ·				E OF CALIFORNIE
-	þ					
			······································	··········		
			****			





### ILS ASSOCIATES, INC.®

Civil Engineering & Land Surveying 79 Galli Drive, Suite A Novato, Ca 94949-5717 (415)883-9200 FAX (415)883-2763

# 898		
	DRAWN:	JOB NO:
	GG	8971
	DATE:	PAGE NO.
	05/29/2015	2 OF 2

HELD FOR

LINE *L1* 

<u>8</u>9

 $\mathcal{S}$ 

6 NON

*@* 

(354.38'())

S32'40'00"E (S32'37

09"E (3)

Õ

5

9

102

101

101

107


9

130

107

## EXHIBIT

APN 034-262-16

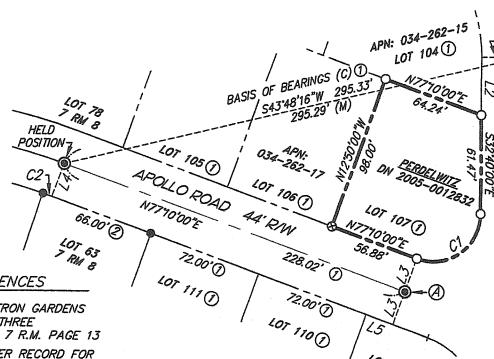

REFERENCES

- (1) BEL VERON GARDENS UNIT THREE BOOK 7 R.M. PAGE 13
- (2) CORNER RECORD FOR APN 034-271-13, FILED JUNE 30, 2011
- (3) RECORD OF SURVEY 2014 RS 50



SCALE: 1" = 60"

#### LINE TABLE

NO.	BEARING	DISTANCE
L1	S57'20'00"W	25.00' ①
L2	S32'40'00"E	36.07' ①
<i>L3</i>	S12'50'00"E	22.00°①
	S12'50'00"E	22.00° ①
<b>L</b> 5	N7770'00"E	18.02° ①

#### CURVE DATA

NO.	RADIUS	DELTA	LENGTH
C1	30'	109'50'04"	<i>57.51'</i> (1)
C2	308'	1'00'07"	6.00' ②

#### LEGEND

- SET 3/4" IRON PIPE WITH YELLOW CAP STAMPED "RCE 18221".
- SET BRASS NAIL AND BRASS TAG STAMPED 8 "RCE 18221".
- FND. 1/2" REBAR WITH YELLOW CAP STAMPED "LS 8080"
- FND. 3" IRON PIPE W/BRASS TAG (ILLEGIBLE) IN STANDARD MONUMENT WELL PER () UNO
- (C) **CALCULATED**
- APN ASSESSOR'S PARCEL NUMBER
- FND. FOUND

(354.38')) RECORD DATA DIFFERS FROM MEASURED PER REFERENCE AS NOTED

- DN DOCUMENT NUMBER
- UNO UNLESS NOTED OTHERWISE
- CC CALCULATED CORNER
- MON MONUMENT

- SURVEY NOTES: (A) FOUND BENT/DISTURBED PIPE IN MONUMENT WELL S6175'21"E 0.05' FROM CC
  - B FOUND &" IRON PIPE WITH LARGE NAIL (DAMAGED) IN MONUMENT WELL